



FORT LEAVENWORTH
LEAVENWORTH, KANSAS
BURGER KING SHOPPETTE PARKING LOT
READY TO ADVERTISE

SOLICITATION NO.: W912DQ-25-B-A003
CONTRACT NO.: W912DQ-25-C-XXXX
ISSUE DATE: AUGUST 2025

INDEX	
Sheet Number	Sheet Title
G-001	COVER SHEET AND INDEX
G-002	GENERAL LEGEND
G-003	LOCATION MAP
V-100	OVERALL EXISTING CONDITIONS
B-100	BORING PLAN VIEW
B-101	BORING LOG
B-102	BORING LOG
B-103	BORING LOG
CD100	OVERALL DEMOLITION PLAN
CS100	OVERALL SITE PLAN
CS101	SITE PLAN
CS102	SITE PLAN
CS103	SITE PLAN
CS300	SITE - RETAINING WALL PLAN & PROFILE
CS301	SITE - RETAINING WALL CROSS SECTIONS
CS500	CIVIL SITE DETAILS
CS501	CIVIL SITE DETAILS
CS502	CIVIL SITE DETAILS
CS503	LVN STANDARD DETAILS
CS504	LVN STANDARD DETAILS
CS505	LVN STANDARD DETAILS
CS506	LVN STANDARD DETAILS
CG100	OVERALL GRADING PLAN
CU300	STORM PIPE PLAN & PROFILE
CP100	OVERALL PAVEMENT PLAN
CP101	PAVEMENT PLAN CONCRETE APPROACH
CC101	CONSTRUCTION PHASING PHASE 1
CC102	CONSTRUCTION PHASING PHASE 2
ED100	ELECTRICAL DEMOLITION PLAN
ES100	ELECTRICAL SITE PLAN
ES500	UTILITY POLE PHOTOS
ES501	UTILITY POLE DETAILS
ES502	PARKING LOT LIGHT POLE AND FIXTURE DETAILS
ES503	JUNCTION CABINET DETAILS
ES504	ELECTRIC UTILITY DETAILS
ES600	ONE-LINE

SIGNATURES AFFIXED BELOW INDICATE OFFICIAL RECOMMENDATION AND APPROVAL OF DRAWINGS IN THIS SET AS INDEXED ON THIS PLATE	
APPROVAL	RECOMMENDED:
	 Digitally signed by BROWN.PHILLIP.REED.1243240766 Date: 2025.08.20 16:15:55 -05'00'
CHIEF, GEOTECHNICAL BRANCH	
DATE: 2025.08.20 16:15:55 -05'00'	
APPROVAL	RECOMMENDED:
	 Digitally signed by BROWN.CARISSA.M.193004083037 DN: CN=BROWN.CARISSA.M.193004083037, OU=PK, O=USDA, OU=U.S. Government, C=US Date: 2025.08.20 12:55:36 -05'00'
CHIEF, DESIGN BRANCH	
DATE: 2025.08.20 12:55:36 -05'00'	
APPROVED:	
	MENSING.SCOTT.P.1385517536 2025.08.20 16:17:27 -05'00'
CHIEF, ENGINEERING DIVISION, P.E.	
DATE: 2025.08.20 16:17:27 -05'00'	
THIS PROJECT WAS DESIGNED BY THE KANSAS CITY DISTRICT OF THE U.S. ARMY CORPS OF ENGINEERS, THE INITIALS OR SIGNATURES AND REGISTRATION DESIGNATIONS OF INDIVIDUALS THAT APPEAR ON THESE PROJECT DOCUMENTS ARE WITHIN THE SCOPE OF THEIR EMPLOYMENT AS REQUIRED BY ER 1110-1-8152.	



U. S. ARMY CORPS OF ENGINEERS KANSAS CITY DISTRICT 601 E. 12TH STREET KANSAS CITY, MO 64106	DESIGNED BY: DRAWN BY: J. JANKE	ISSUE DATE: JULY 27, 1967 SHEET NO. SHEET NO. SHEET NO.
	CHECKED BY: B. ESTVANKO APPROVED BY: P. BROWN	SOLID NO. CONTRACT NO.
	SIZE:	


FORT LEAVENWORTH, KANSAS
BURGER KING - SHOPPETTE PARKING

COVER SHEET AND INDEX

SHEET ID

G-001

READY TO ADVERTISE

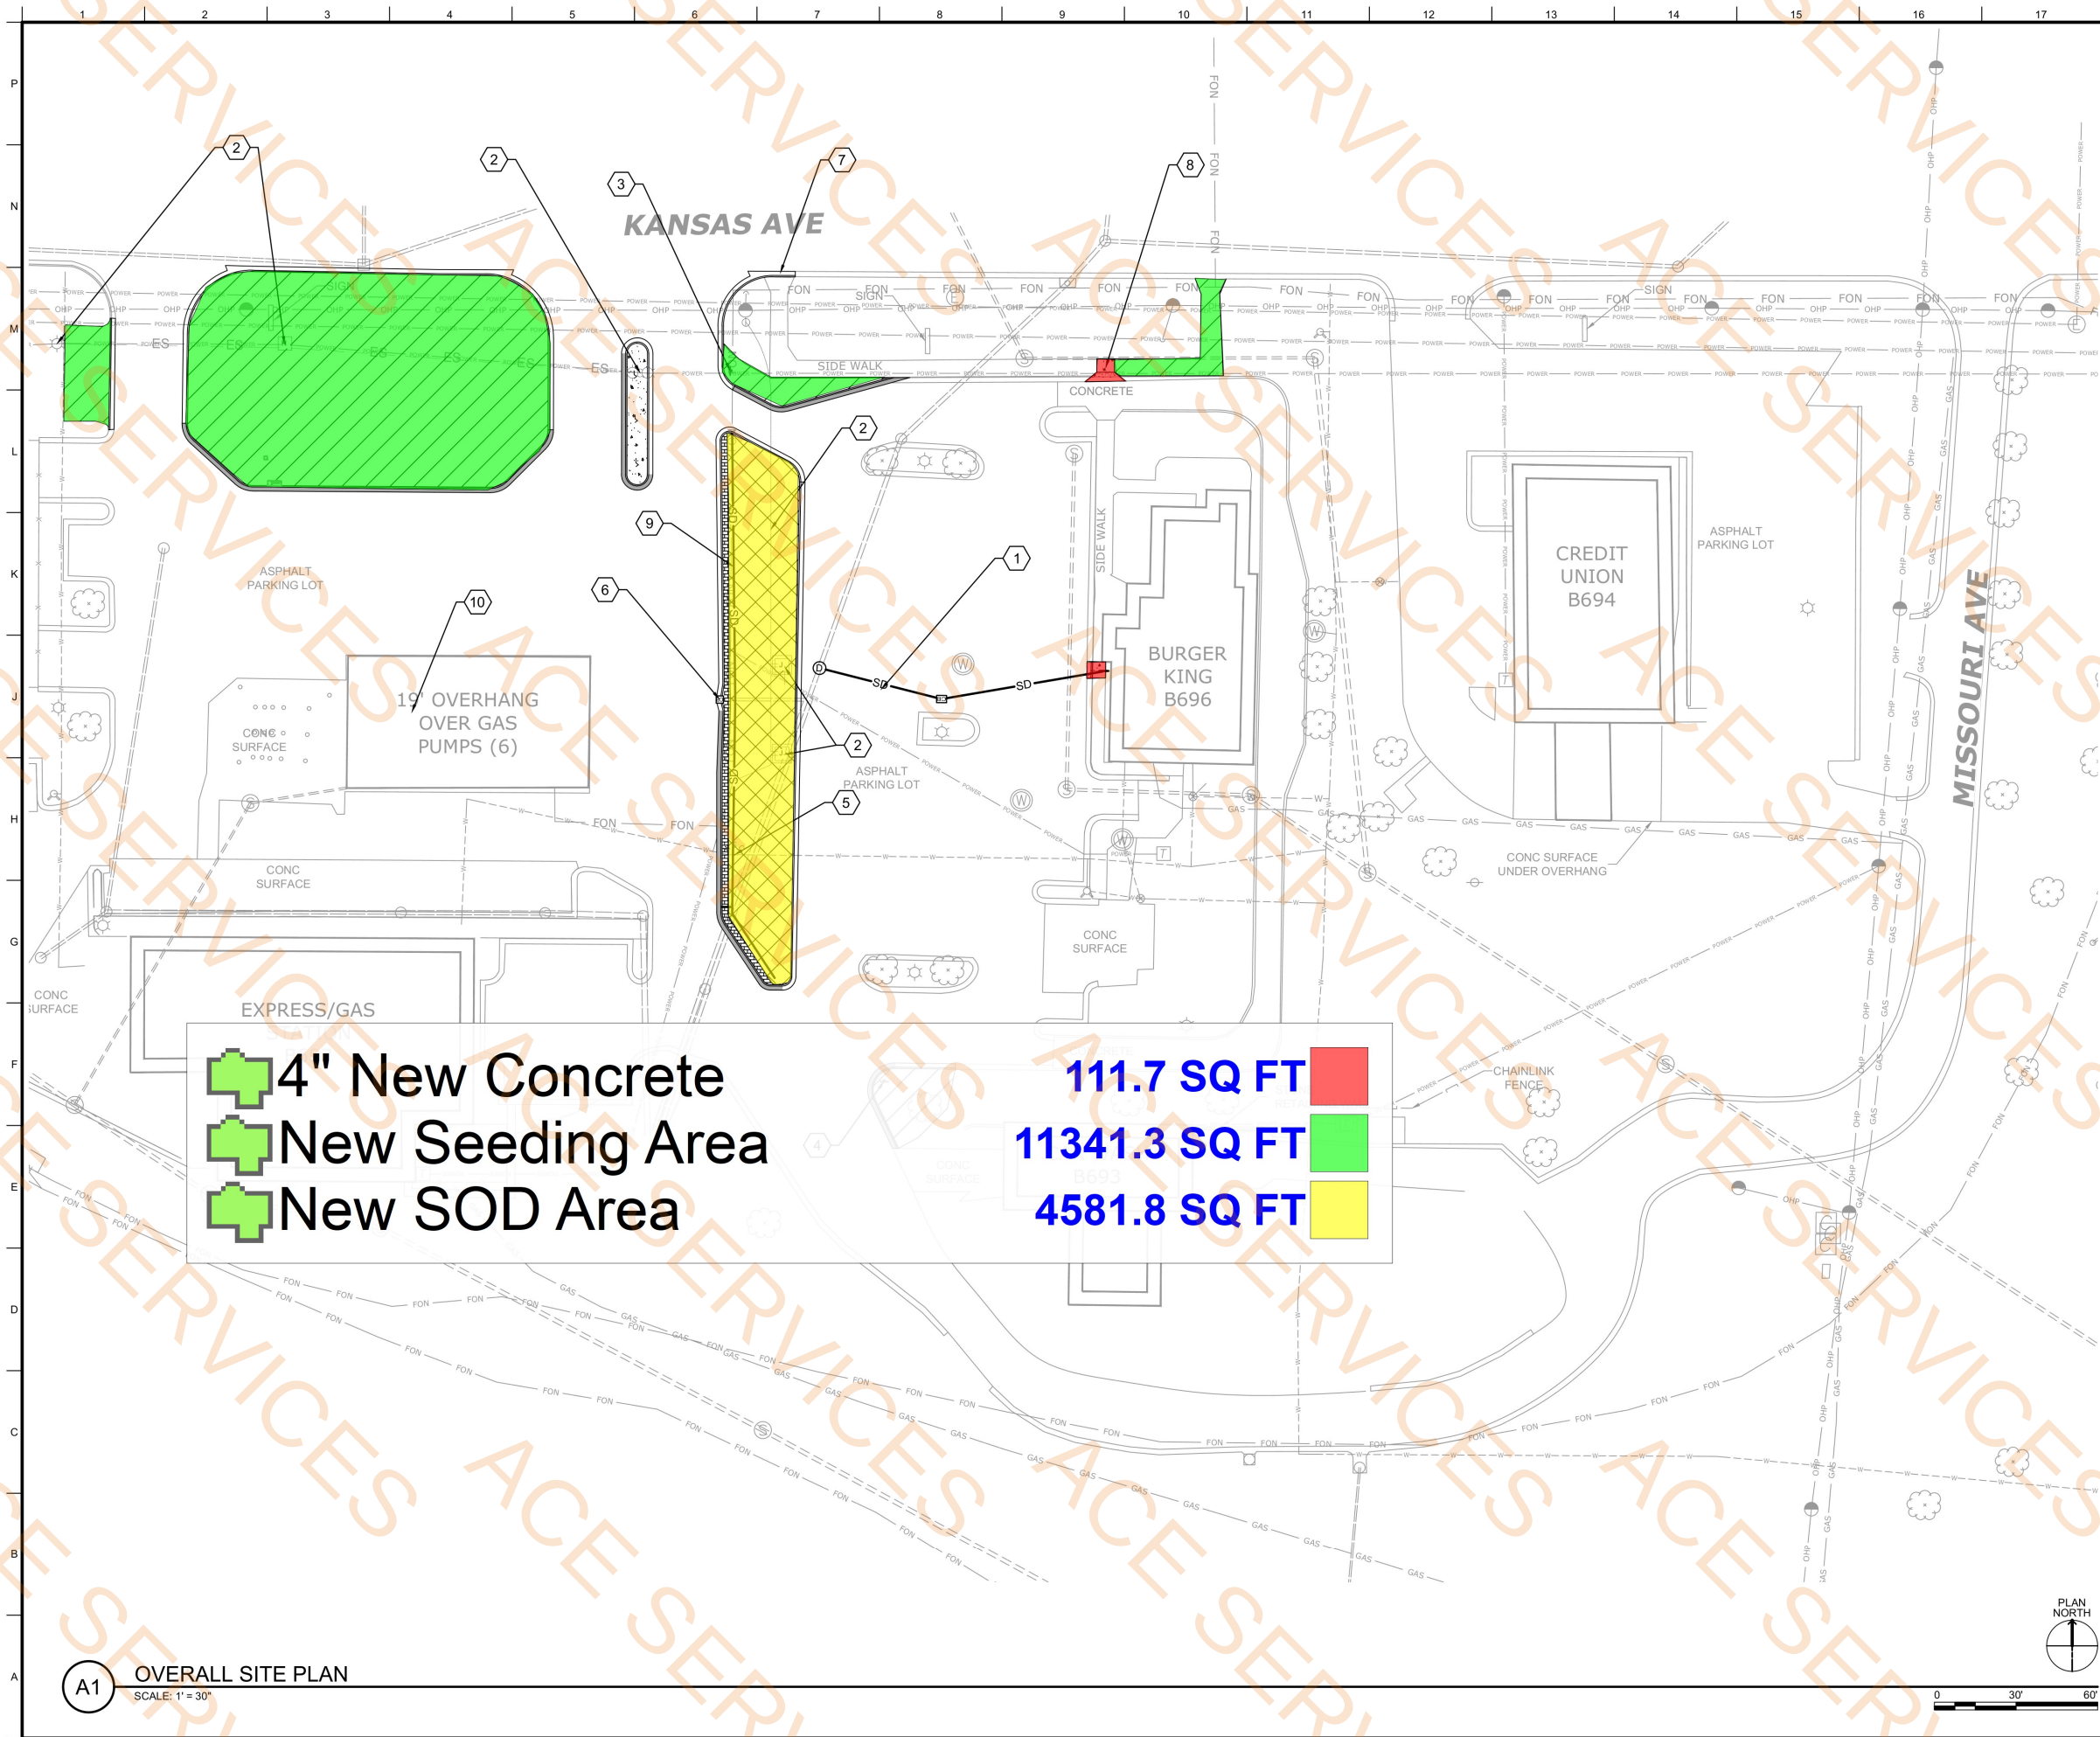

GENERAL SHEET NOTES:

1. SEE SHEETS CP100 AND CP101 FOR PAVEMENT PLANS.



US Army Corps
of Engineers®

SHEET KEY NOTES:

1. PROPOSED STORM ADDITION. SEE SHEET CU300.
2. PROPOSED ELECTRICAL. SEE SHEETS ED100 THRU ES800.
3. INSTALL DO NOT ENTER SIGN.
4. RELOCATED SIGN (BY OTHERS).
5. REPLACE WATER VALVE BOX RISER. SEE SHEET CS500 DETAILS.
6. POUR AND GRADE GUTTER AROUND EXISTING INLET.
7. TIE CURB AND GUTTER INTO EXISTING SIDEWALK RAMP. MATCH EXISTING ELEVATIONS.
8. CONSTRUCT SIDEWALK RAMP IN ACCORDANCE WITH LEAVENWORTH CIVIL STANDARD DETAILS. SEE SHEET CS506.
9. PROPOSED WALL DRAIN. SEE SHEET CS300 AND SHEET CS301.
10. STRIP, PRIME, AND PAINT METAL BANDS AT GAS PUMPS. SEE DETAIL A9 ON SHEET CS501.

LEGEND:

ITEM	
	WET CURB AND GUTTER, SEE E1/CS503
	DRY CURB AND GUTTER, SEE A1/CS503
	SEEDING
	SOD
	LIMESTONE BLOCK RETAINING WALL
	4" CONCRETE

DESIGNED BY: A. MARSH	ISSUE DATE: AUGUST 2025
DRAWN BY: J. JANKE	SOLICITATION NO.: P2-566956
CHECKED BY: B. ESTVANKO	CONTRACT NO.:
SUBMITTED BY: J. JANKE	DATE:
SIZE: ANSI D	MARK:
DESCRIPTION:	DATE:

FORT LEAVENWORTH, KANSAS
Burger King - Shopette Parking
P2-566956, P22025

OVERALL SITE PLAN

SHEET ID

CS100

READY TO ADVERTISE

