


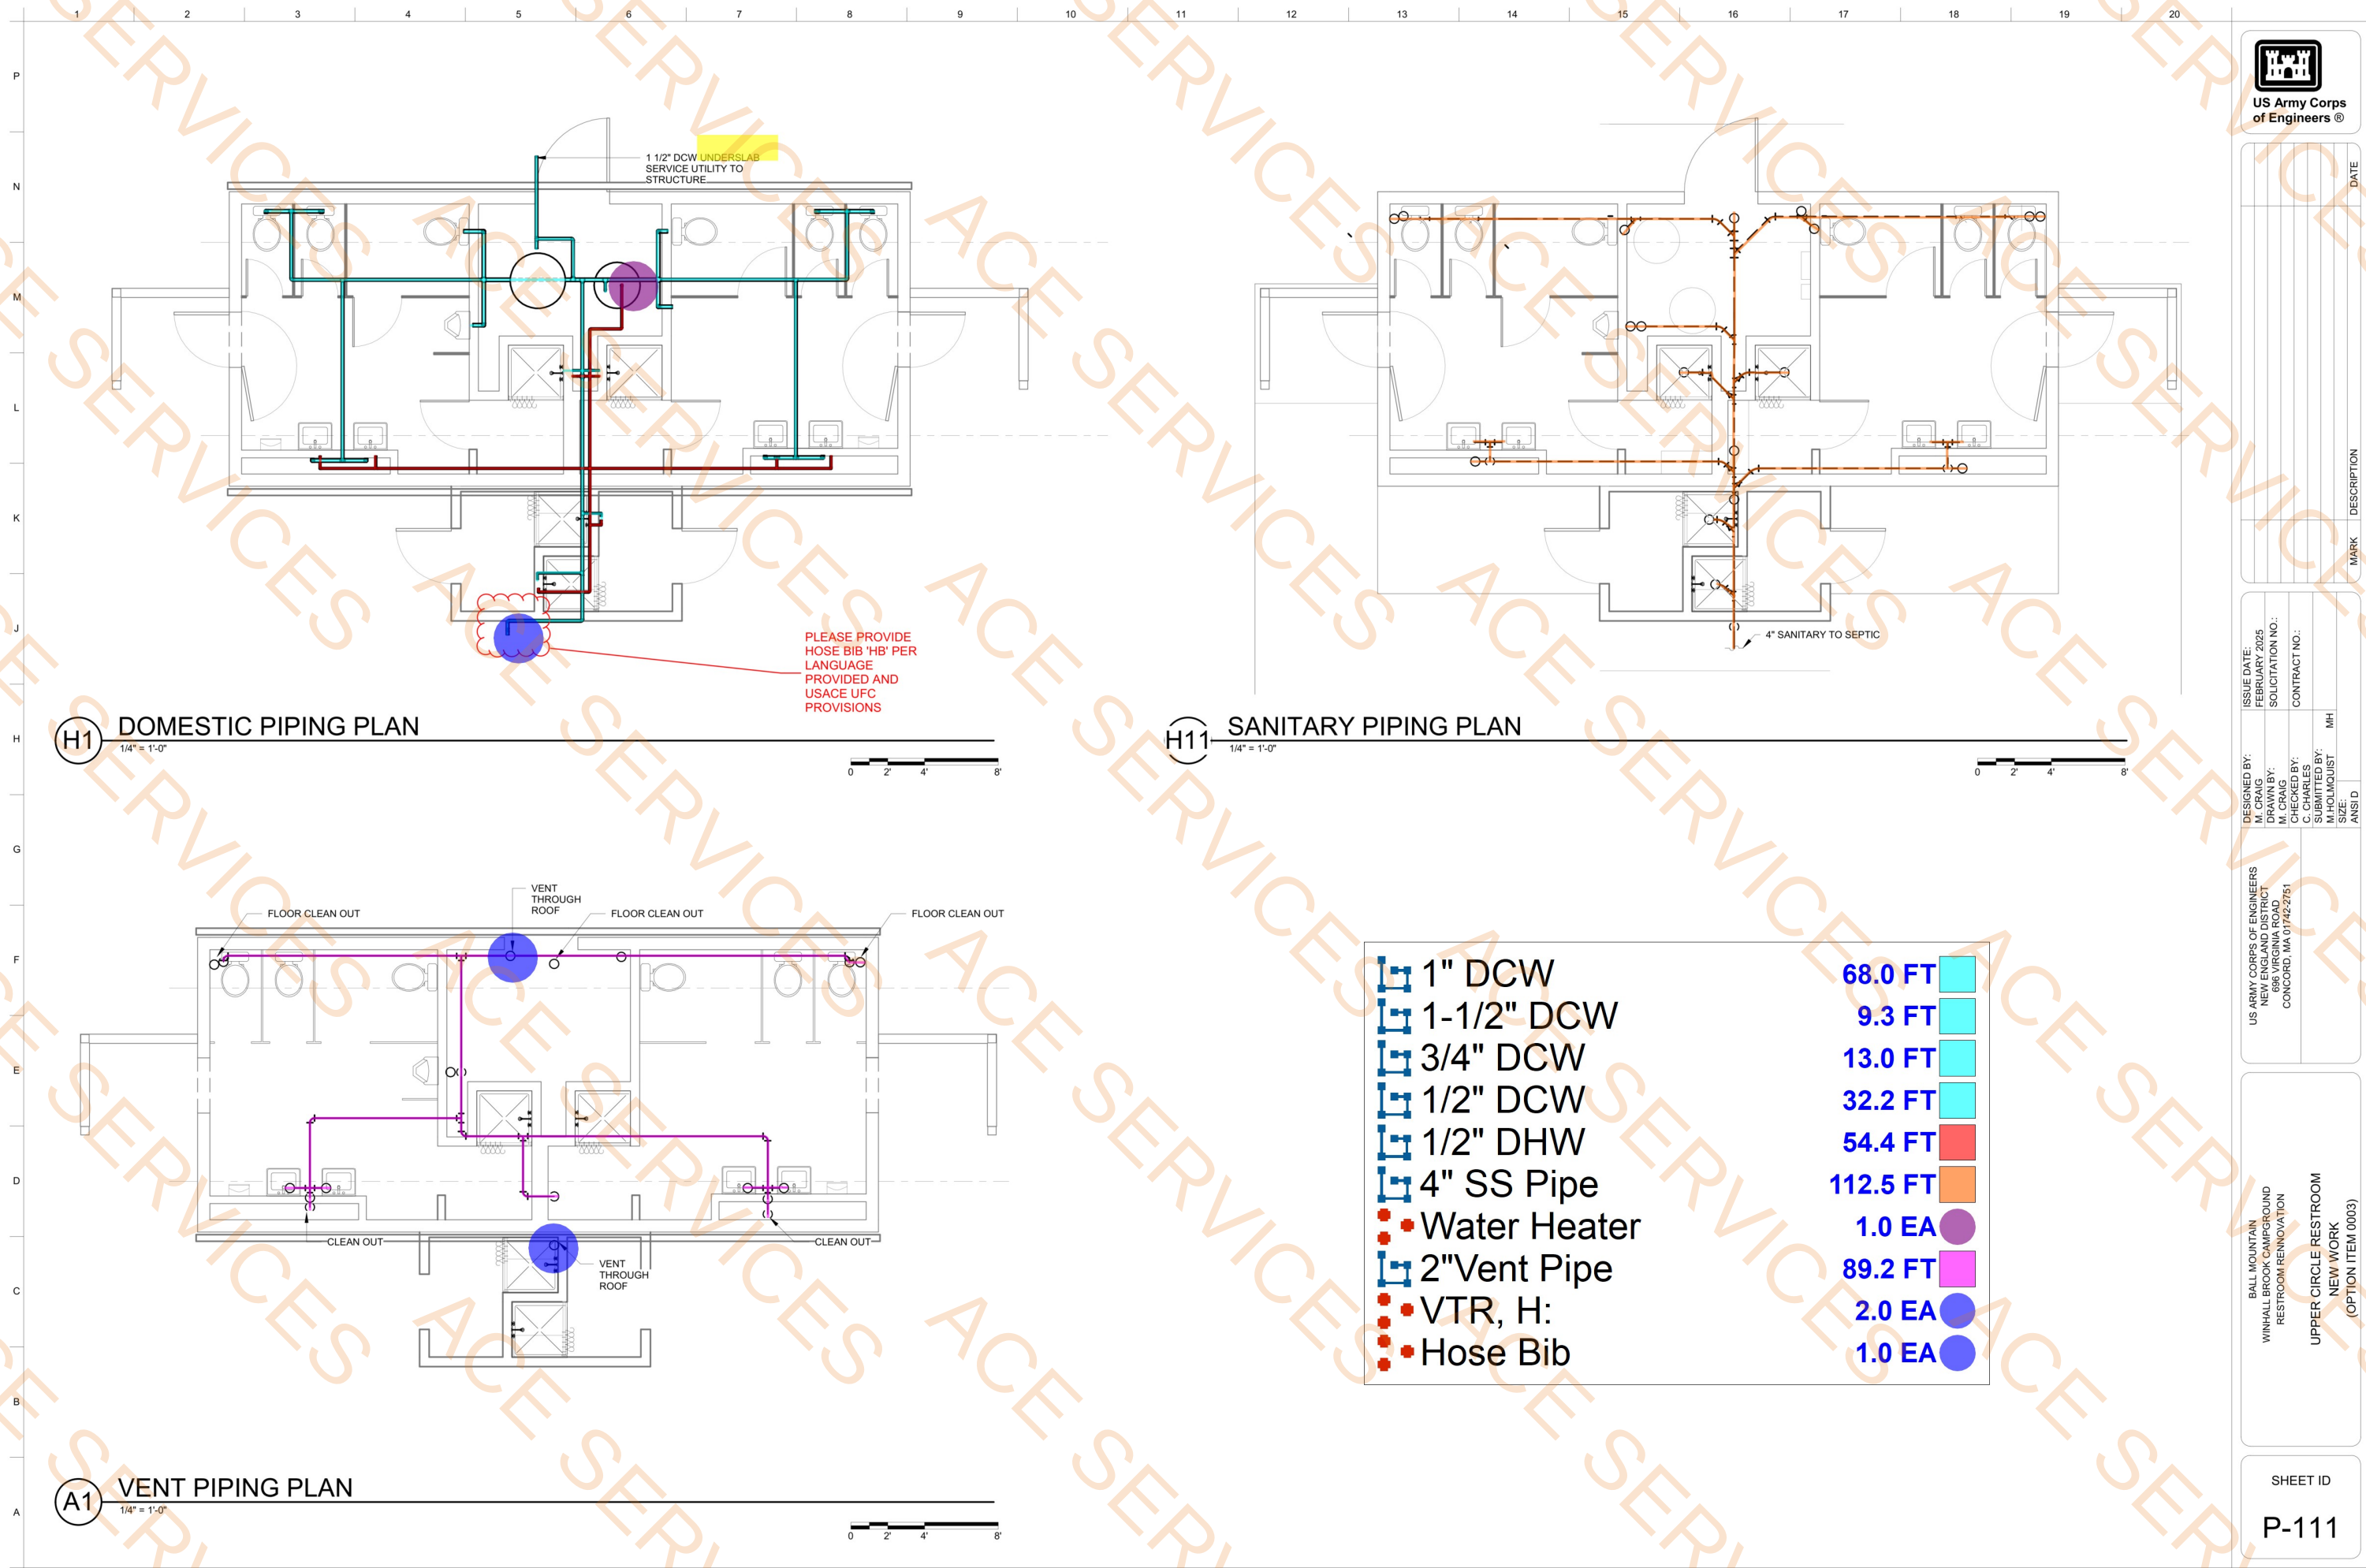


DATE
DESCRIPTION
MARK

ISSUE DATE: FEBRUARY 2025	CONTRACT NO.:
SOLICITATION NO.:	
DESIGNED BY: M. CRAIG	CHECKED BY: C. CHARLES
DRAWN BY: NEW ENGLAND DISTRICT 686 VIRGINIA ROAD CONCORD, MA 01742-2751	SUBMITTED BY: M. HOLMQUIST
	SIZE: ANSI D

US ARMY CORPS OF ENGINEERS NEW ENGLAND DISTRICT 686 VIRGINIA ROAD CONCORD, MA 01742-2751	BALL MOUNTAIN WINHALL BROOK CAMPGROUND RESTROOM RENOVATION UPPER CIRCLE RESTROOM NEW WORK (OPTION ITEM 0003)
---	---

SHEET ID
P-111

Plot Date: 9/30/2024 3:17:20 PM File Path: C:\Users\EDDMAC\Documents\COA-BM-519 - Upper Circle_Map_EEDDMAC.rvt

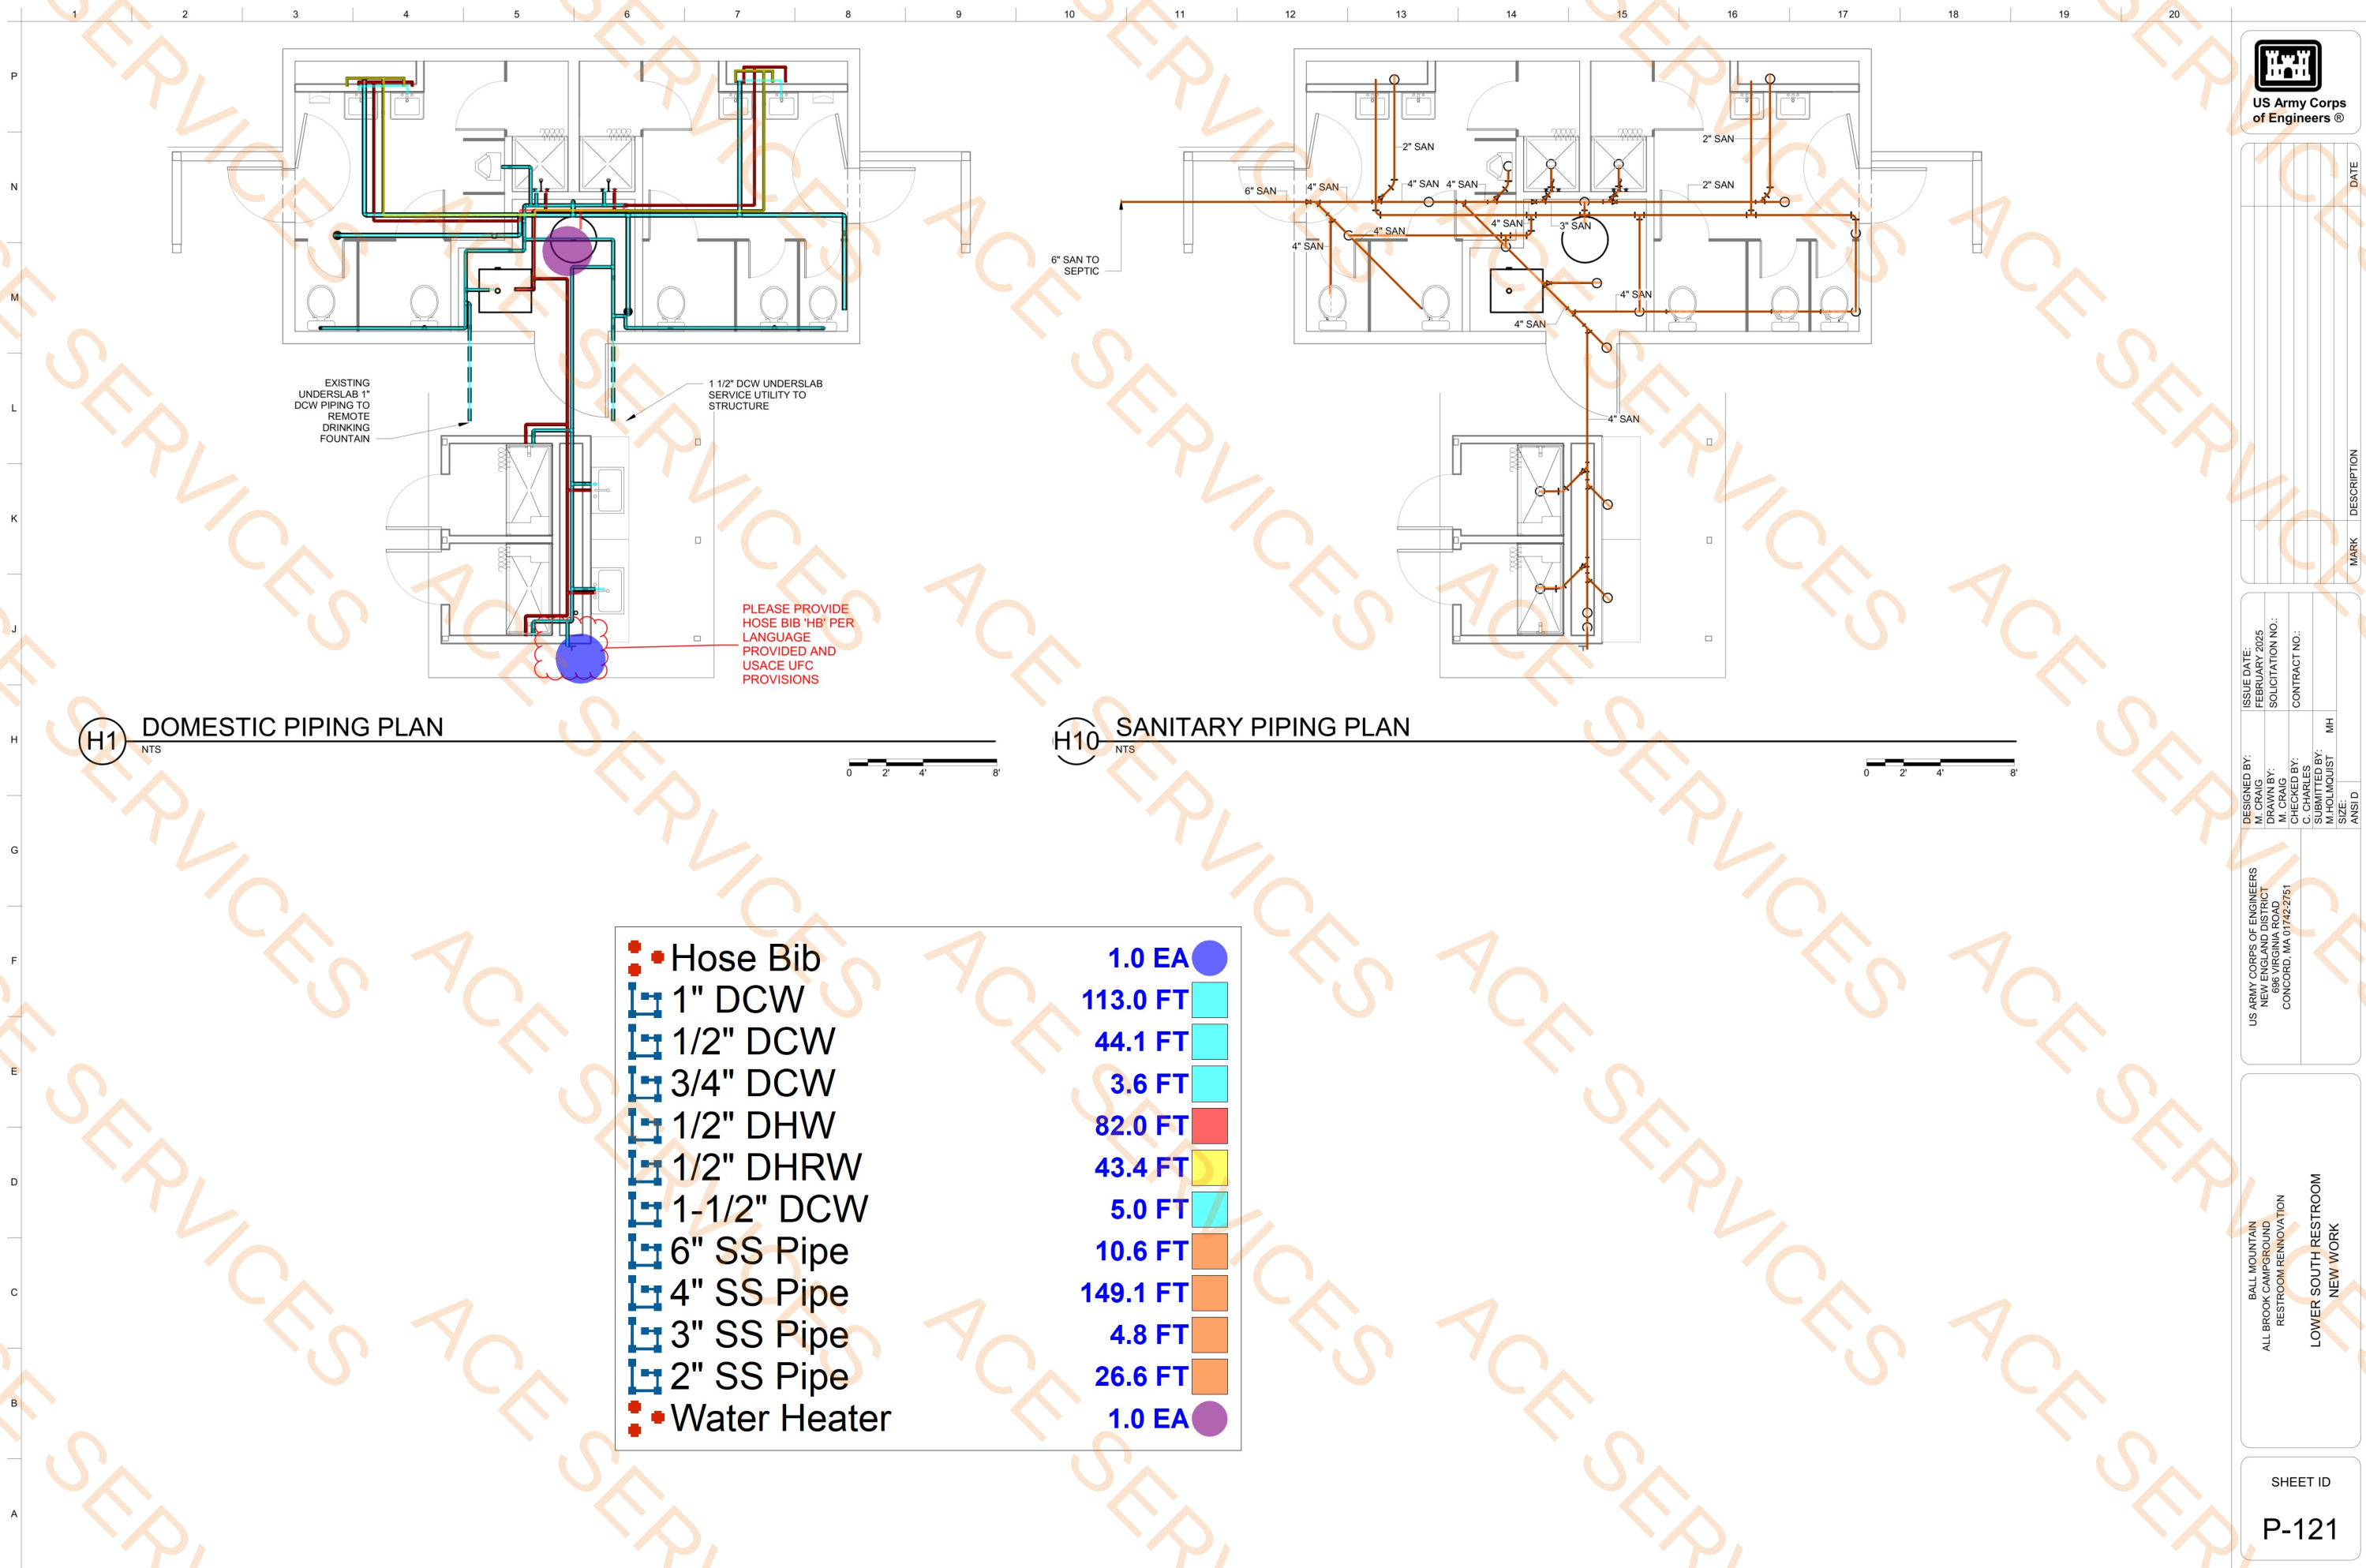

US ARMY CORPS OF ENGINEERS
NEW ENGLAND DISTRICT
696 VIRGINIA ROAD
CONCORD, MA 01742-2751

DESIGNED BY: M. CRAIG
DRAWN BY: J. BROWN
CHECKED BY: C. CHARLES
SUBMITTED BY: M. HOLMQUIST
SIZE: ANS/D

ISSUE DATE: FEBRUARY 2025
SOLICITATION NO.:
CONTRACT NO.:

BALL MOUNTAIN
ALL BROOK CAMPGROUND
RESTROOM RENOVATION
LOWER SOUTH RESTROOM
NEW WORK

SHEET ID
P-121

