


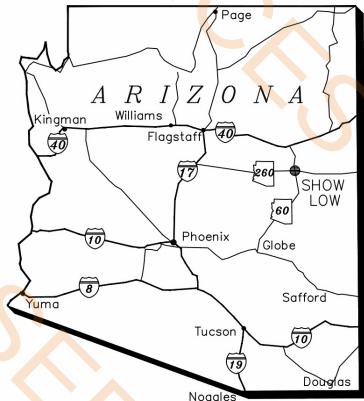

LOCATION MAP

SERVING UTILITIES

WATER - CITY OF SHOW LOW
SEWER - CITY OF SHOW LOW
ELECTRIC - NAVOPACHE ELECTRIC
GAS - UNISOURCE ENERGY
TELEPHONE - FRONTIER
TV - CABLE ONE


ESTIMATED QUANTITIES LIST

- SAWCUT AND REMOVE EXISTING ASPHALT 475 SY
REMOVE EXISTING SOIL 285 CY
REMOVE CULVERT/DRAINAGE PIPE 185 LF
REMOVE ASPHALT DRIVEWAY 275 SY
REMOVE ROCK DRIVEWAY 20 CY
REMOVE CONCRETE DRIVEWAY 3150 SF
RELOCATE TRAFFIC SIGN 2 EA
RELOCATE FIRE HYDRANT 1 EA
RELOCATE AND RECONNECT WATER METER 6 EA
ESTABLISH ROADSIDE DITCH 170 LF
INSTALL 18" SLOPED HEAD 1 EA
INSTALL 6" C900 PVC WATERLINE 6 LF
INSTALL 8" BASE REPAIR 25 CY
INSTALL ASPHALT 230 TONS
INSTALL 8" ABC BASE 185 CY
INSTALL 2' RIBBON CURB 3306 LF
INSTALL 3" ABC CURB BASE 65 CY
INSTALL 18" CMP CULVERT 32 LF
INSTALL 12" CMP CULVERT 150 LF
INSTALL STORM DRAIN MANHOLE BASE 1 EA
RAISE EXISTING WATER VALVE 2 EA
RAISE EXISTING MANHOLE 2 EA
RAISE EXISTING WATER METER 1 EA
RAISE EXISTING SEWER CLEAN OUT WITH COLLAR 1 EA
REPLACE ASPHALT DRIVEWAY 1500 SF
REPLACE ROCK DRIVEWAY 1300 SF
REPLACE CONCRETE DRIVEWAY 2500 SF

COUNTRY CLUB MANOR AND ESTATES
36TH DR CURB

COSL #5002653

A PORTION OF SECTION 14, TOWNSHIP 10 NORTH, RANGE 21 EAST
OF THE GILA AND SALT RIVER MERIDIAN
CITY OF SHOW LOW, NAVAJO COUNTY, ARIZONA

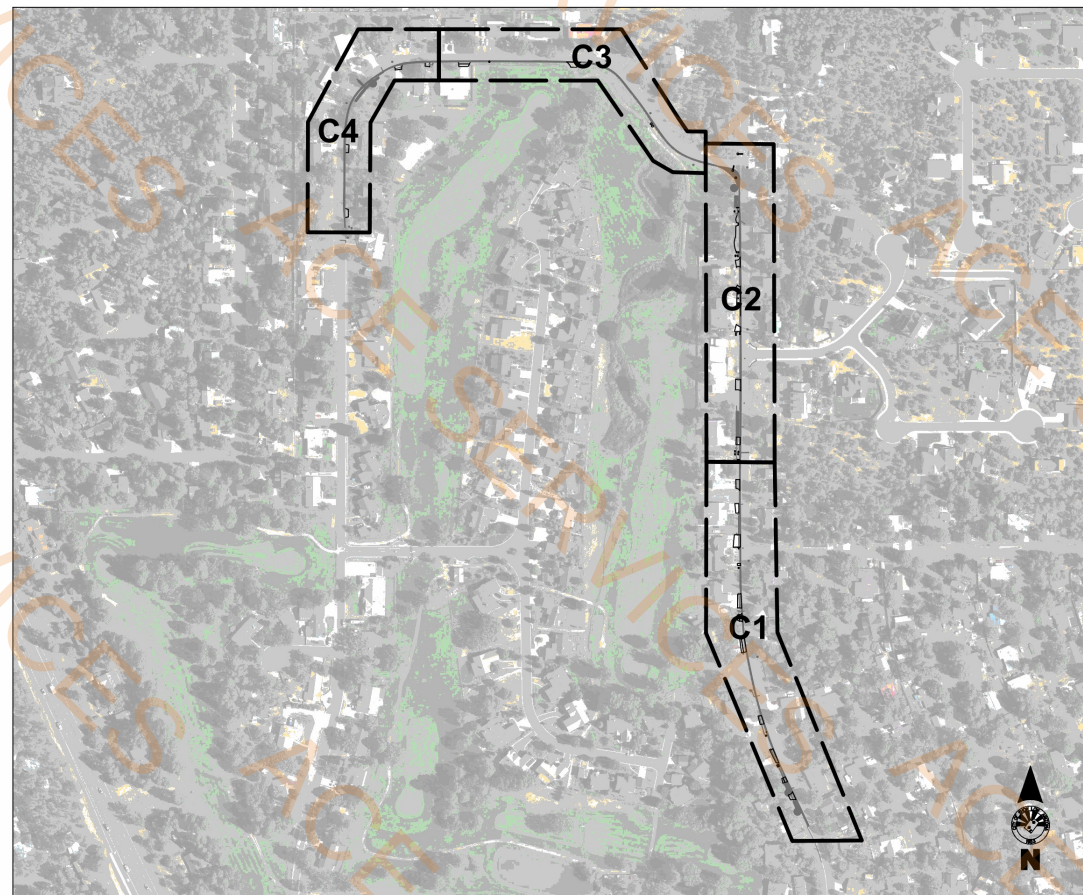

PROJECT AREA MAP

SHEET INDEX

COVER SHEET
NOTES SHEET
DETAILS SHEET
EXISTING CONDITIONS SHEET
CONSTRUCTION SHEET


1, G-1
2, G-2
3, D-1
4 - 7, EX-1 ; EX-4
8-11, C-1 ; C-4

BASIS OF BEARING

THE BASIS OF BEARINGS SHOW HEREON IS ASSUMED STATE PLANE
NAD 1983 COORDINATE SYSTEM

LEGEND

- EXISTING TREE
-P- EXISTING ELECTRIC LINE
-T- EXISTING TELEPHONE LINE
-S- EXISTING SEWER LINE
-W- EXISTING WATER LINE
-O-O EXISTING FENCE
- - - EXISTING CMP CULVERT

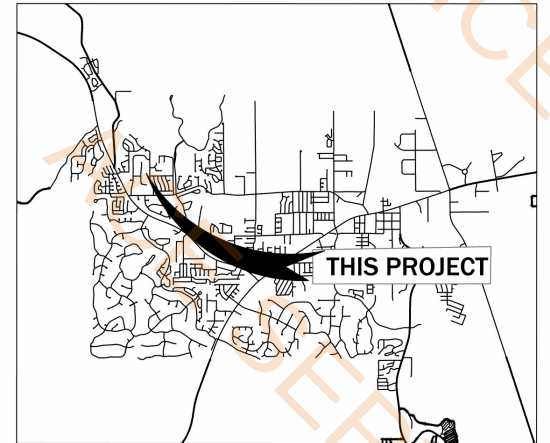

VICINITY MAP

MAYOR: JOHN LEECH, JR

VICE MAYOR: CONNIE KAKAVAS

CITY COUNCIL:

JON ADAMS
BRANDT CLARK
GENTRY HATCH
BRYCE JUDD
DERIK WHIPPLE

CITY MANAGER: MORGAN BROWN

PUBLIC WORKS DIRECTOR: SHANE HEMESATH, P.E.

APPROVAL

CITY OF SHOW LOW PUBLIC WORKS DIRECTOR

3/13/26

DATE

DATE PROJECTION INFO:
AZ EAST NAD 83
WELL 5 OUTSIDE
88888
UNITS: FT
DATE PUBLISHED: March 12, 2026
FILE NAME: S:\PW\Secretary\PROJECTS\2. OUT TO BID\5002653 36th Drive Curb\1 CAD\36th Dr Curb.dwg





City of SHOW LOW
Arizona
"NAMED BY THE TURN OF A CARD"

**CITY OF SHOW LOW
ENGINEERING DIVISION**
180 N. 9th Street
Show Low, Arizona 86001
Ph. (928) 532-4080
Fax (928) 532-4009

COVER SHEET
36TH DR CURB
ROADWAY IMPROVEMENTS PROJECT

DRN-RTL	DATE: 03/26	SHEET #	SHEET
DES-RTL	DATE: 03/26	1 OF 11	G-1
CHD-RTL	DATE: 03/26		

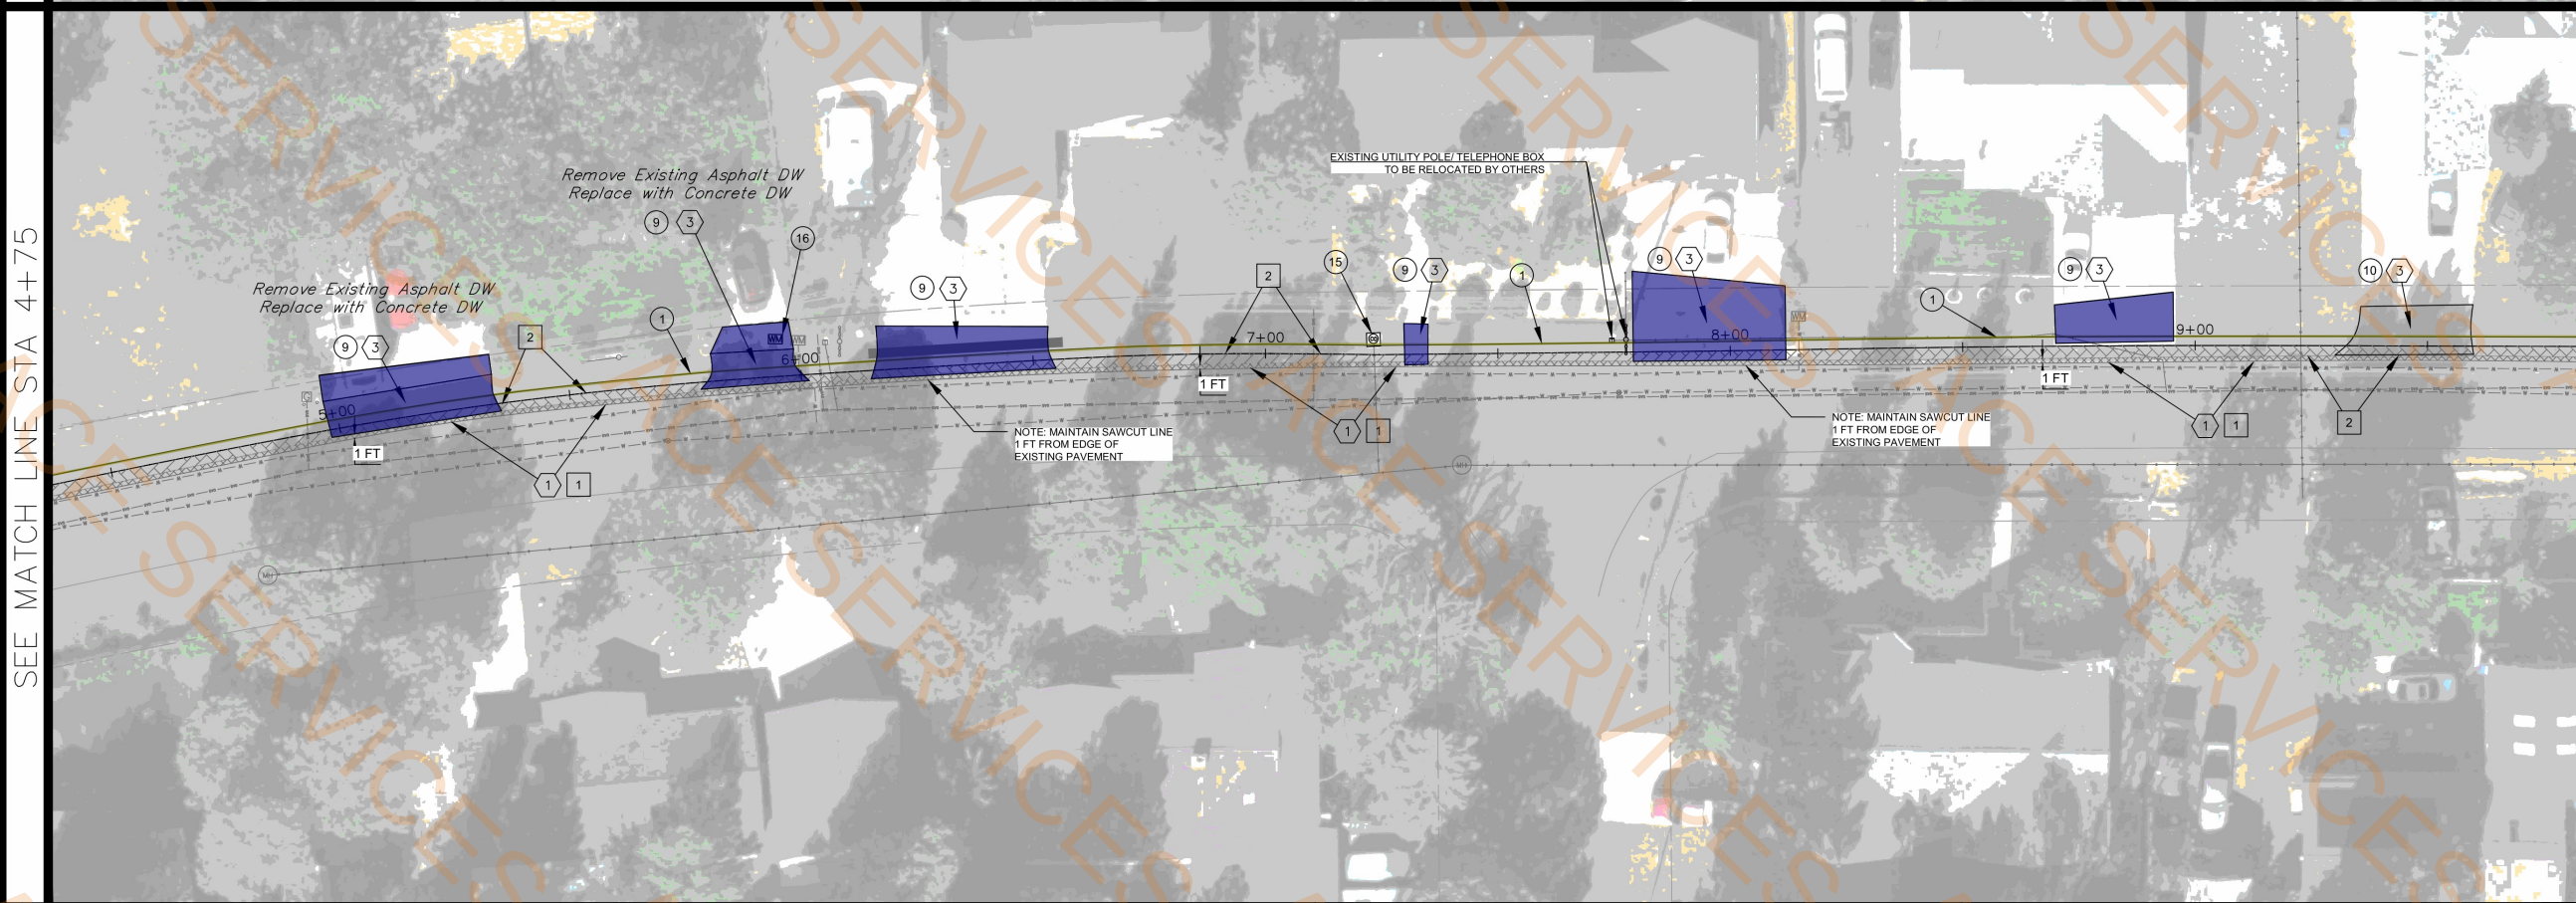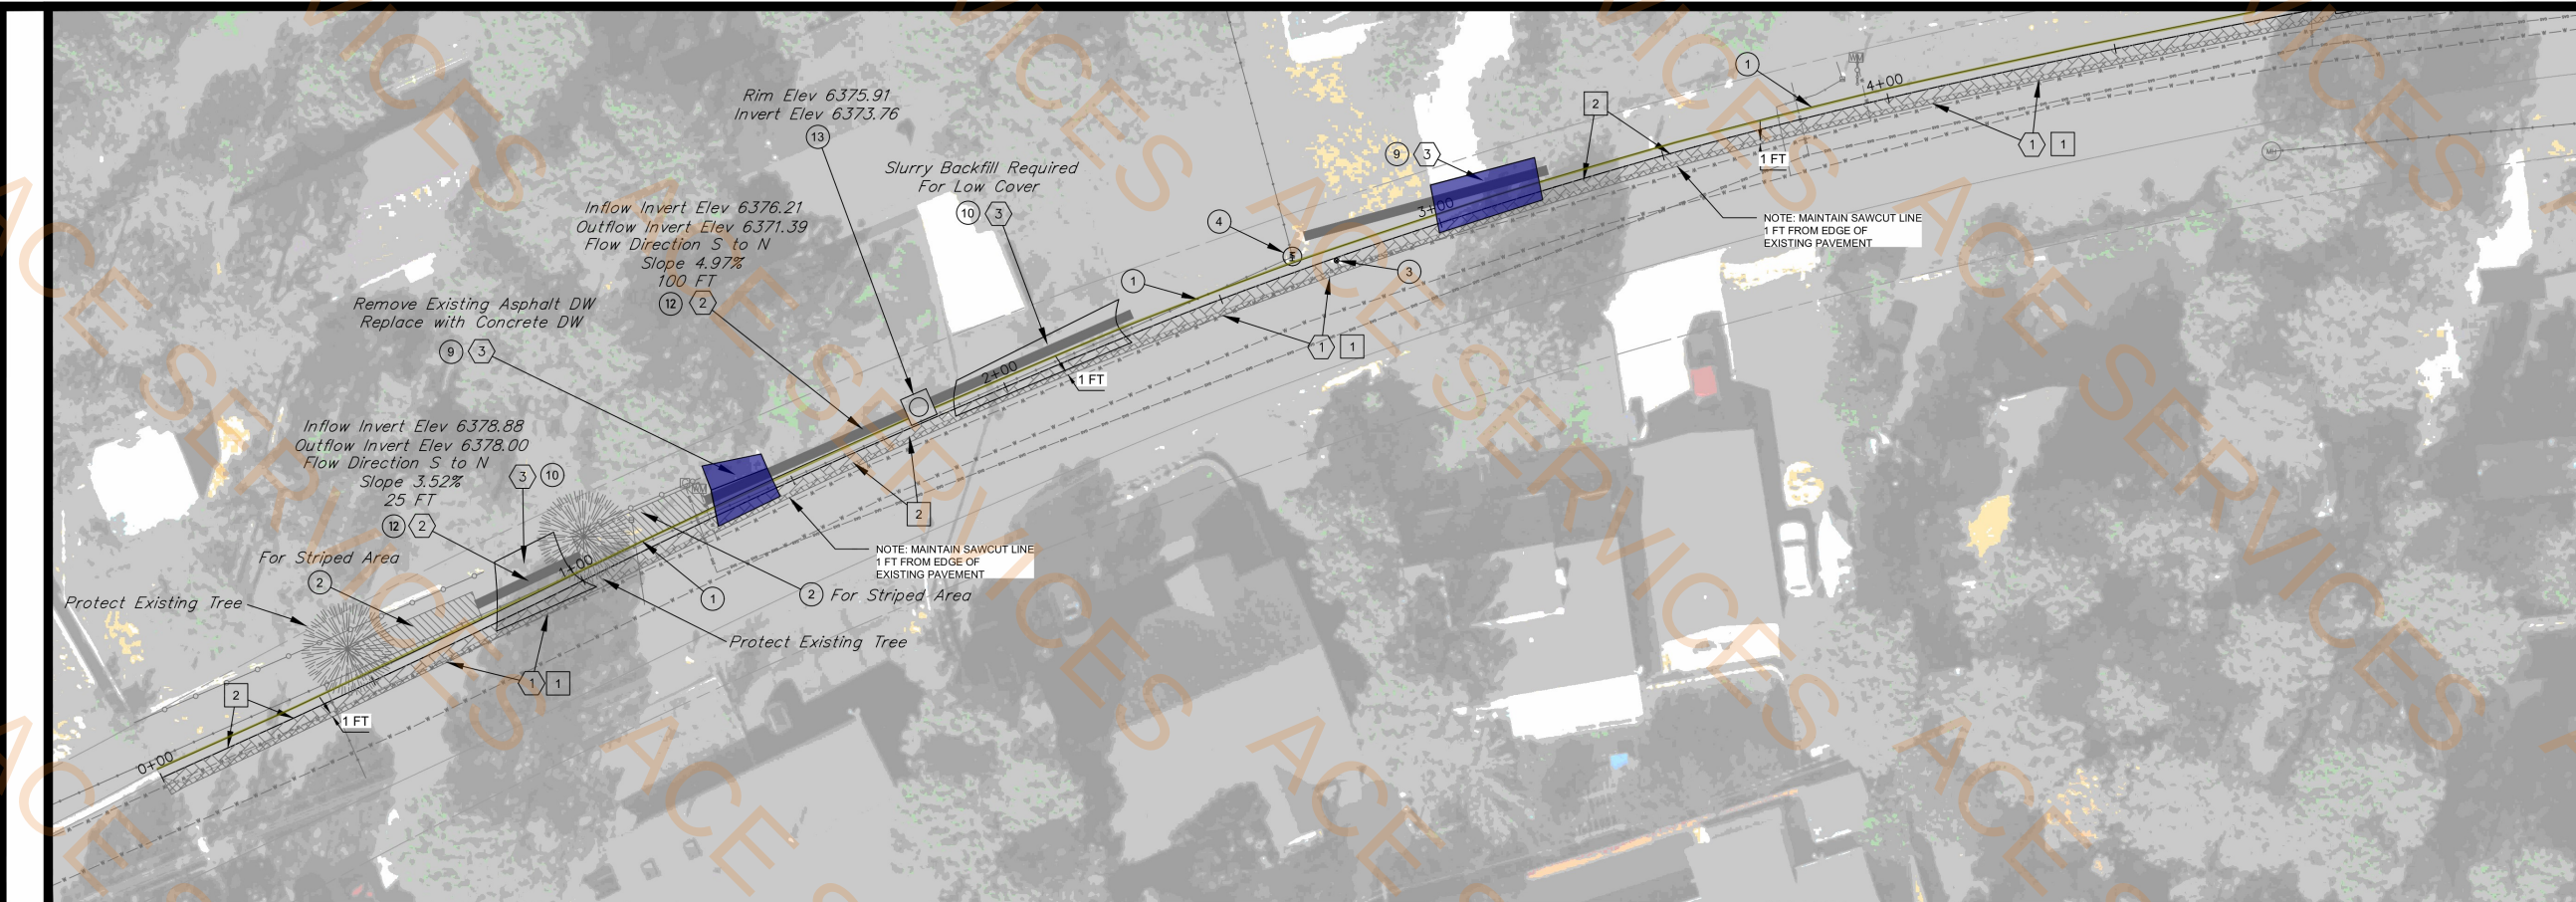

REMOVAL NOTES

- 1 Remove Asphalt
- 2 Remove Existing Culvert/Drainage Pipe
- 3 Remove Driveway (Asphalt, Concrete, or Rock)

PAVEMENT NOTES

- 1 Install 3" AC Pavement
- 2 Install 3" AC Pavement Over 8" ABC Base

CONSTRUCTION NOTES

- 1 Install Ribbon Curb Per MAG Std Dtl 220 "Type B", See Detail B for Grading
- 2 Establish Drainage Ditch
- 3 Raise Existing Water Valve
- 4 Raise Existing Manhole
- 9 Remove and Replace Concrete Driveway/Sidewalk See Detail Note A
- 10 Remove and Replace Asphalt Driveway See Detail Note A
- 12 Install 12" CMP Culvert
- 13 Install Storm Drain Manhole Base
- 15 Raise Existing Sewer Clean Out With Collar
- 16 Raise Existing Water Meter to New Concrete Driveway

THE CONTRACTOR FOR THE PROJECT SHALL NOT PLACE AND PERMANENT PAVEMENT UNTIL SLEEVING FOR ELECTRIC, GAS, TELEPHONE, CABLE TV, SITE IRRIGATION, OR ANY OTHER UNDERGROUND UTILITY HAS BEEN INSTALLED. IT SHALL BE THE CONTRACTOR'S RESPONSIBILITY TO CONFIRM THAT ALL SLEEVING IS IN PLACE PRIOR TO PLACEMENT OF THE PERMANENT PAVEMENT.



**CITY OF SHOW LOW
ENGINEERING DIVISION**
180 N. 9th Street
Show Low, Arizona 86001
Ph. (928) 532-4080
Fax (928) 532-4009

CONSTRUCTION SHEET

36TH DR CURB ROADWAY IMPROVEMENTS PROJECT			
DRN/RTL	DATE: 03/26	SHEET #	SHEET
DES/RTL	DATE: 03/26	8 OF 11	C-1
CHD/RTL	DATE: 03/26		


**Install Ribbon Curb
Concrete Driveway**

1021.6 FT
2326.2 SQ FT



SEE MATCH LINE STA 9+75 SHEET 8

SEE MATCH LINE STA 14+75

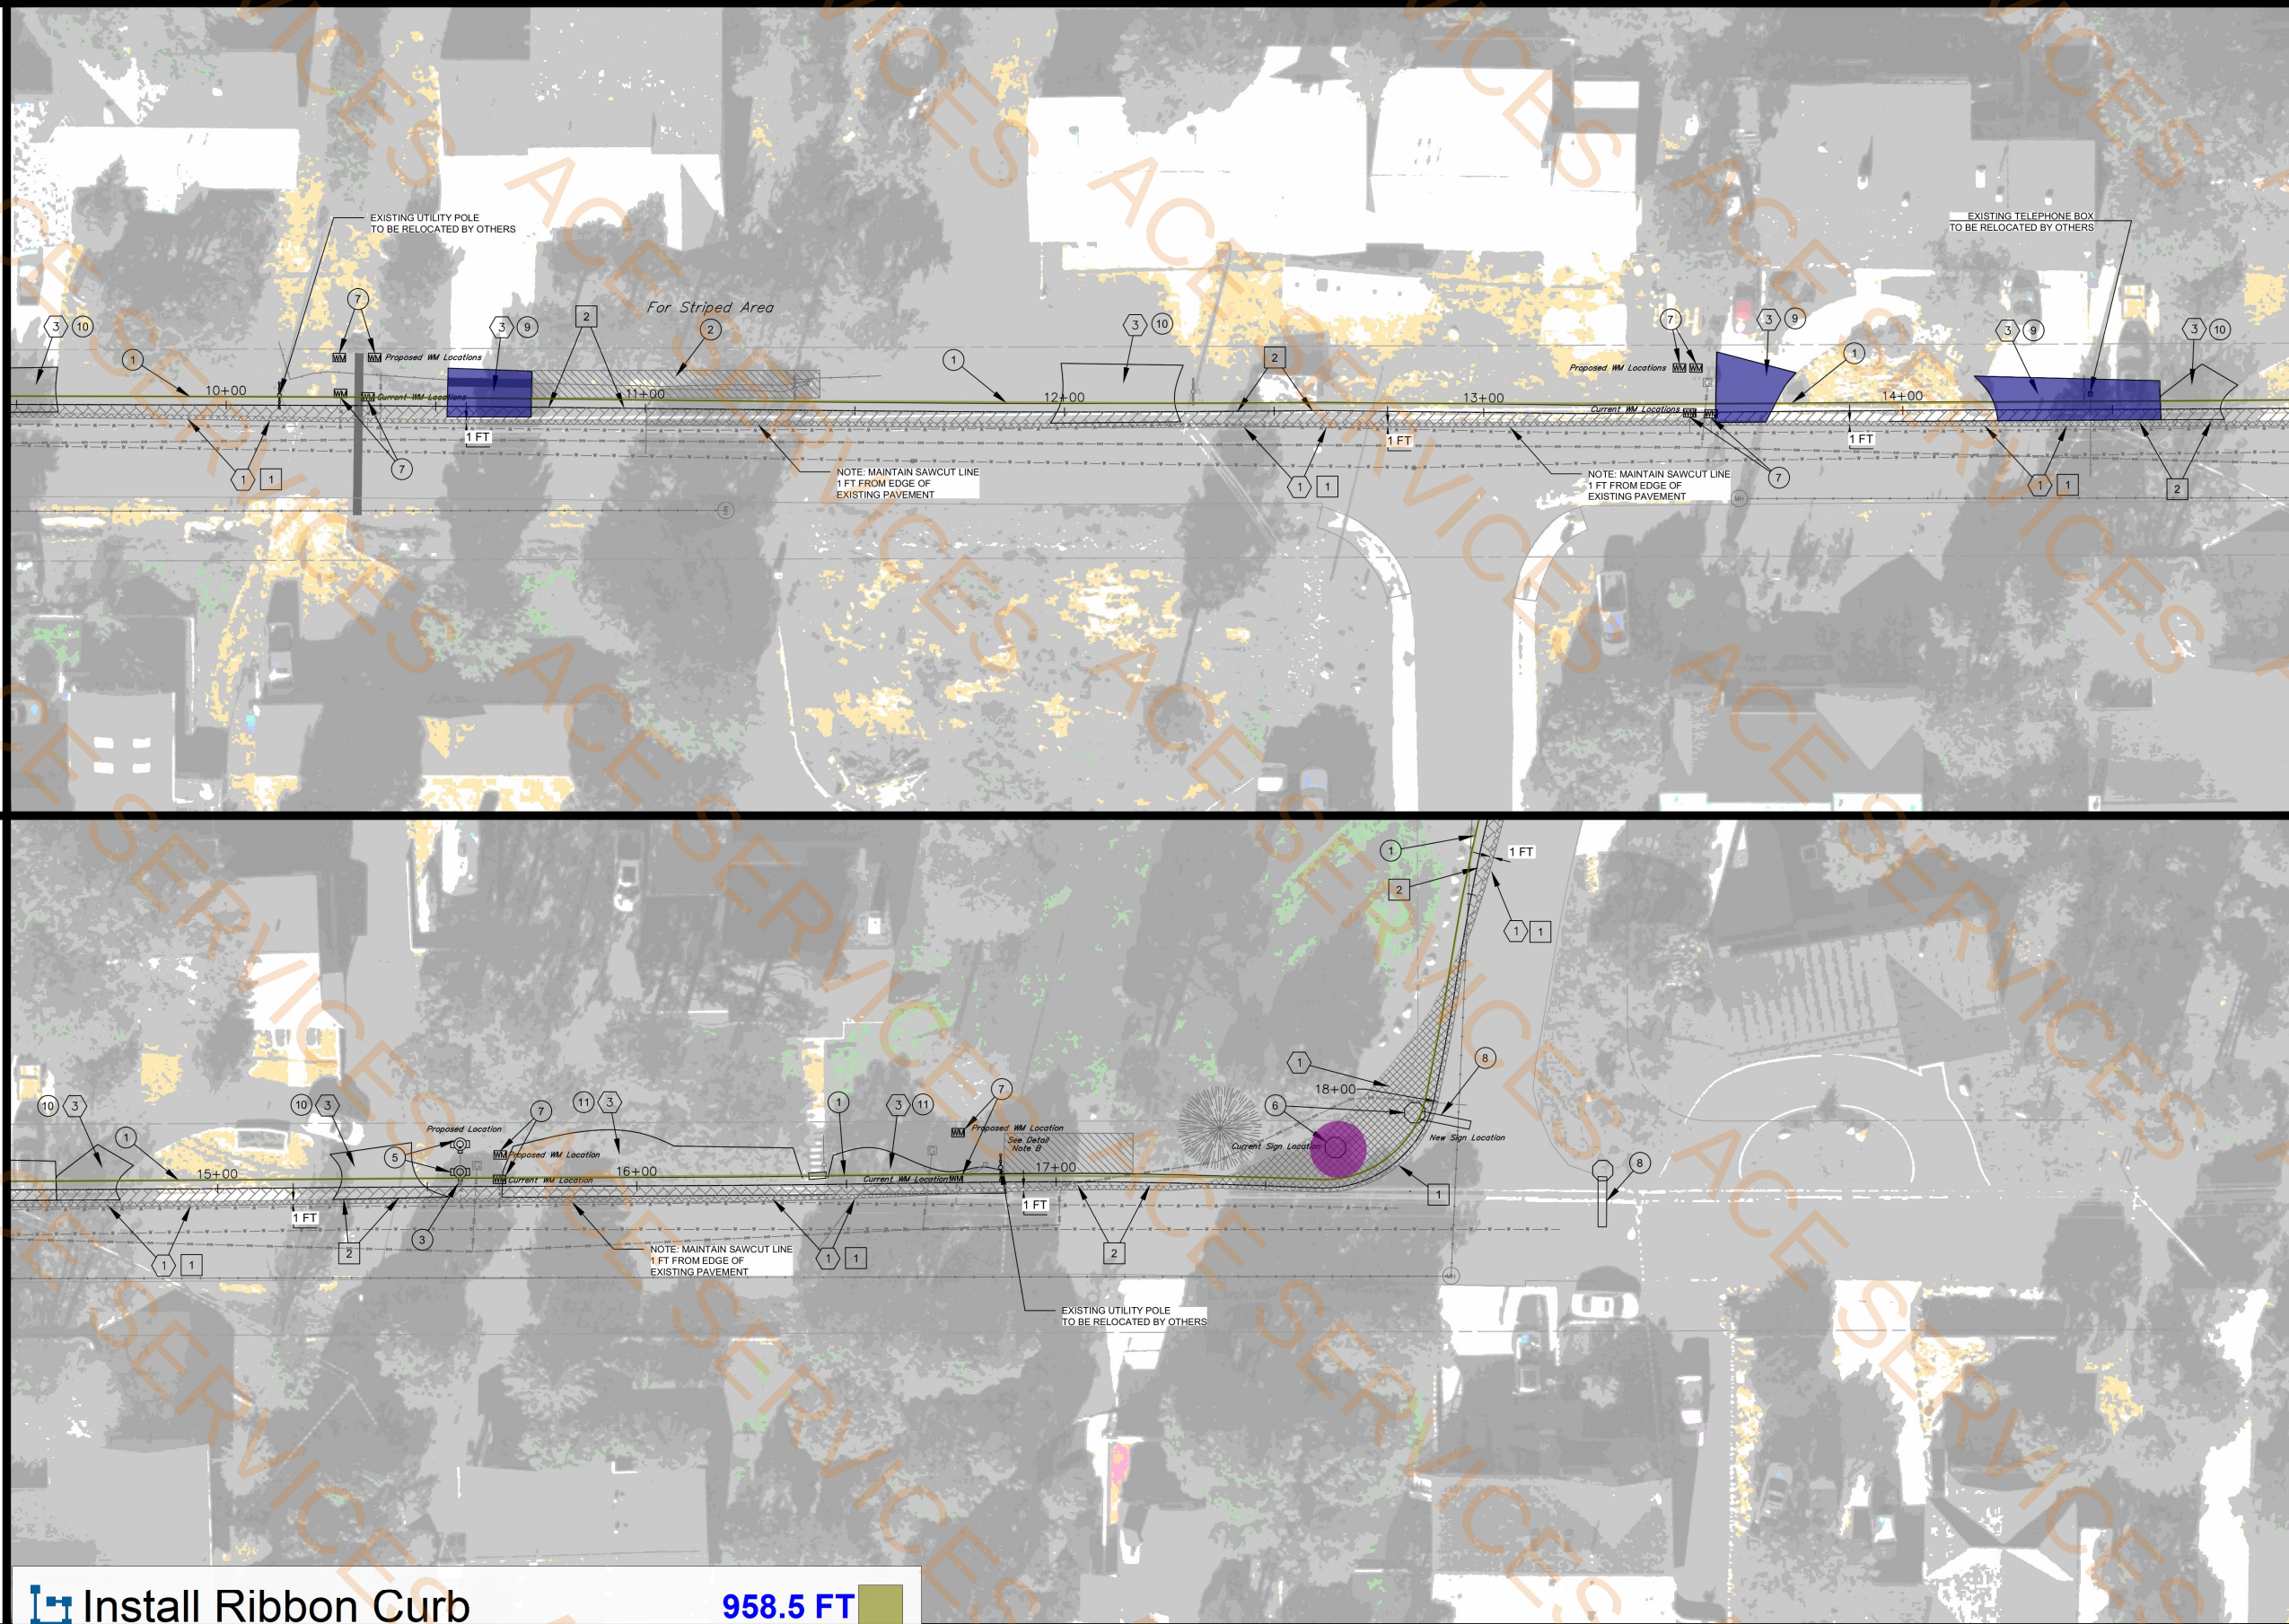


- Install Ribbon Curb
- Concrete Driveway
- Traffic Sign Footing

958.5 FT

853.7 SQ FT

1.0 EA

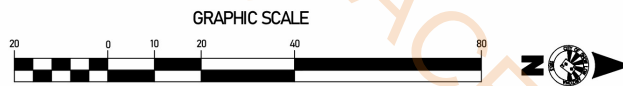

REMOVAL NOTES

- Remove Asphalt
- Remove Driveway (Asphalt, Concrete, or Rock)

PAVEMENT NOTES

- Install 3" AC Pavement
- Install 3" AC Pavement Over 8" ABC Base

CONSTRUCTION NOTES

- Install Ribbon Curb Per MAG Std Dtl 220 "Type B", See Detail B for Grading
- Establish Drainage Ditch
- Raise Existing Water Valve
- Relocate Existing Fire Hydrant Per COSL Std Dtl W-07A Extend 6" Water Main From Existing Fire Hydrant
- Relocate Existing Traffic Sign
- Relocate and Reconnect Water Meter to Private Water Connection
- Install Stop Bar
- Remove and Replace Concrete Driveway See Detail Note A
- Remove and Replace Asphalt Driveway See Detail Note A
- Remove and Replace Rock Driveway See Detail Note A

THE CONTRACTOR FOR THE PROJECT SHALL NOT PLACE AND PERMANENT PAVEMENT UNTIL SLEEVING FOR ELECTRIC, GAS, TELEPHONE, CABLE TV, SITE IRRIGATION, OR ANY OTHER UNDERGROUND UTILITY HAS BEEN INSTALLED. IT SHALL BE THE CONTRACTORS RESPONSIBILITY TO CONFIRM THAT ALL SLEEVING IS IN PLACE PRIOR TO PLACEMENT OF THE PERMANENT PAVEMENT.



**City of
SHOW LOW
Arizona**
"NAMED BY THE TURN OF A CARD"

CITY OF SHOW LOW ENGINEERING DIVISION


180 N. 9th Street
Show Low, Arizona 85901
Ph. (928) 532-4080
Fax (928) 532-4009

CONSTRUCTION SHEET


36TH DR CURB ROADWAY IMPROVEMENTS PROJECT

DRN/RTL	DATE: 03/26	SHEET #	SHEET
DES/RTL	DATE: 03/26	9 OF 11	C-2
CHD/RTL	DATE: 03/26		

SEE MATCH LINE STA 21+50

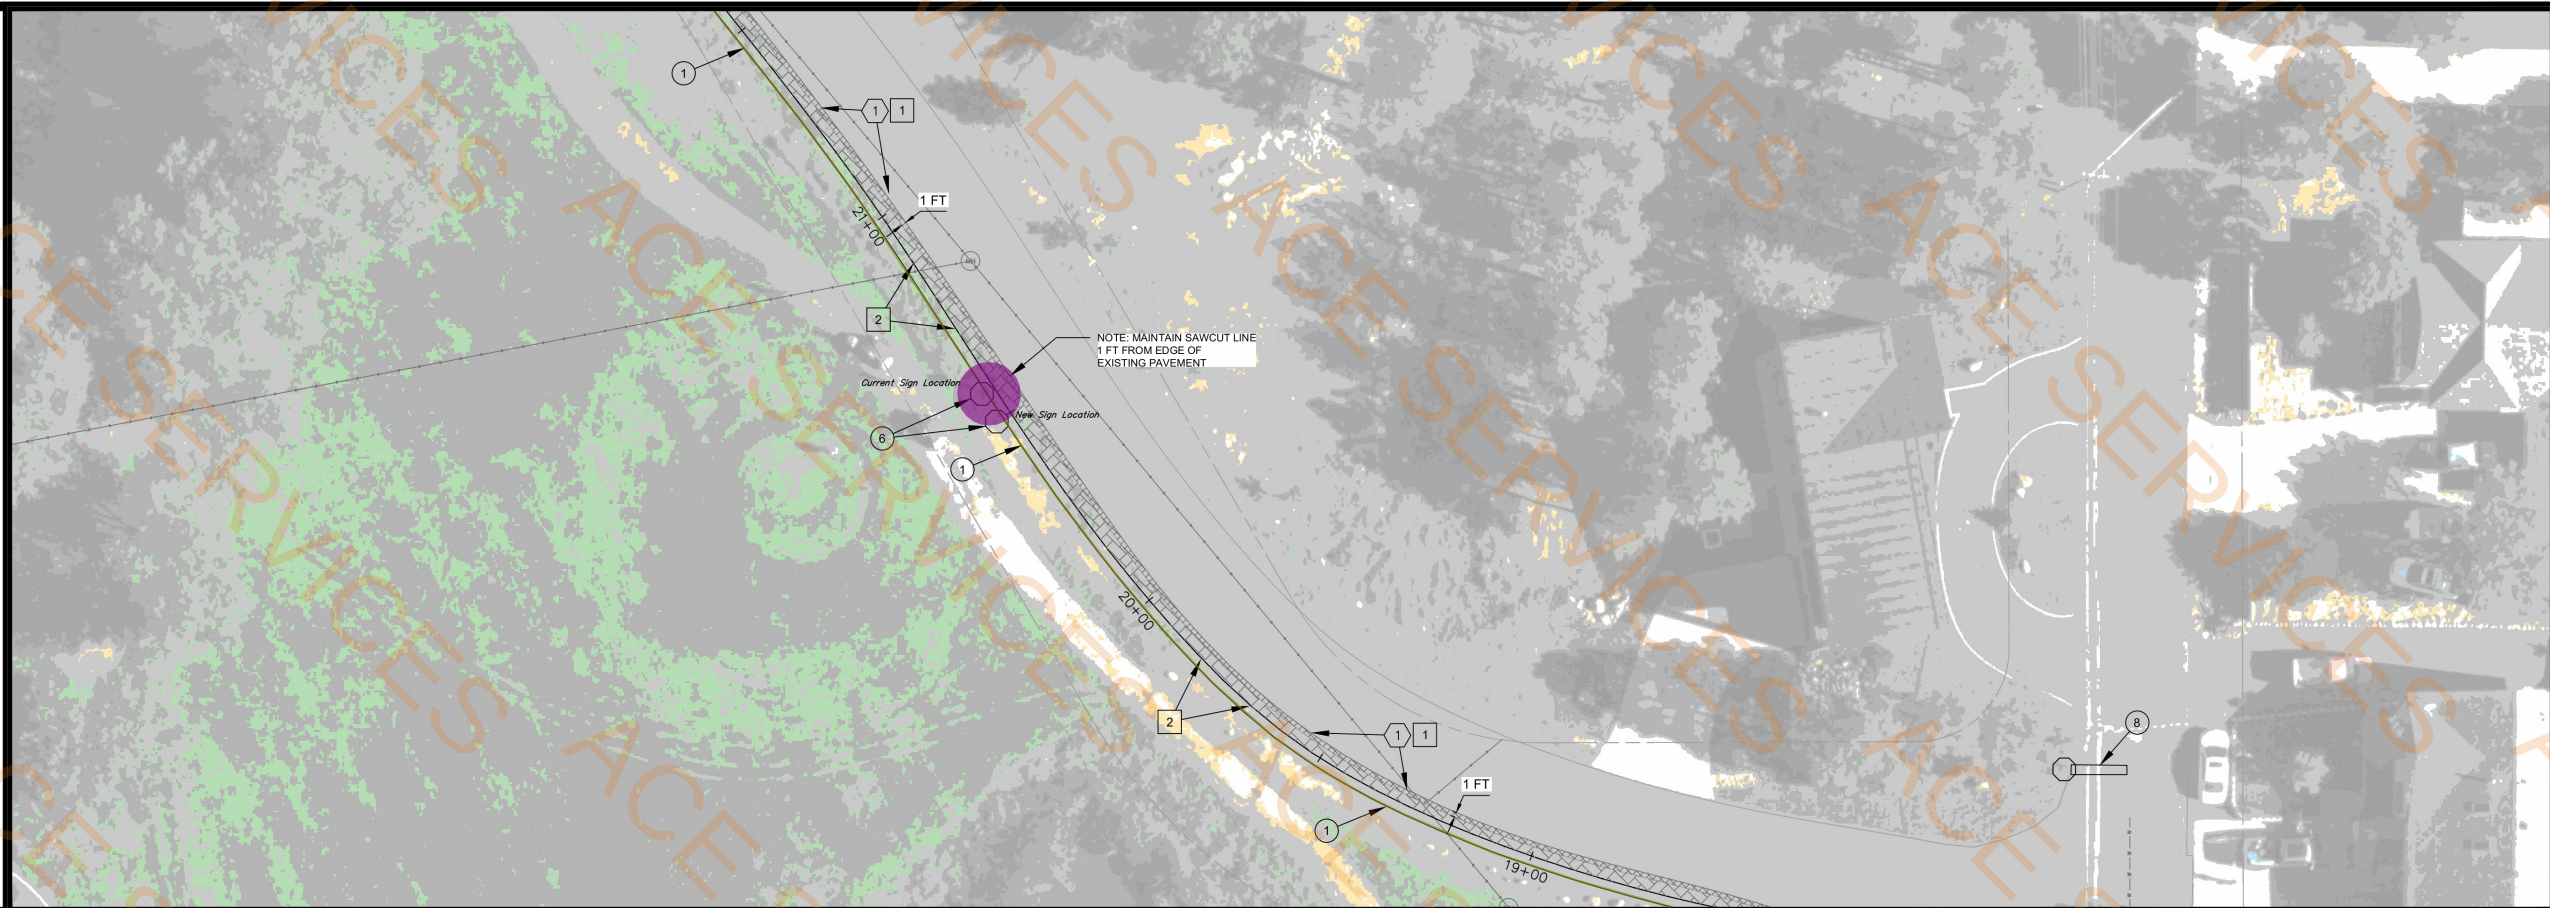

SEE MATCH LINE STA 26+75 SHEET 11

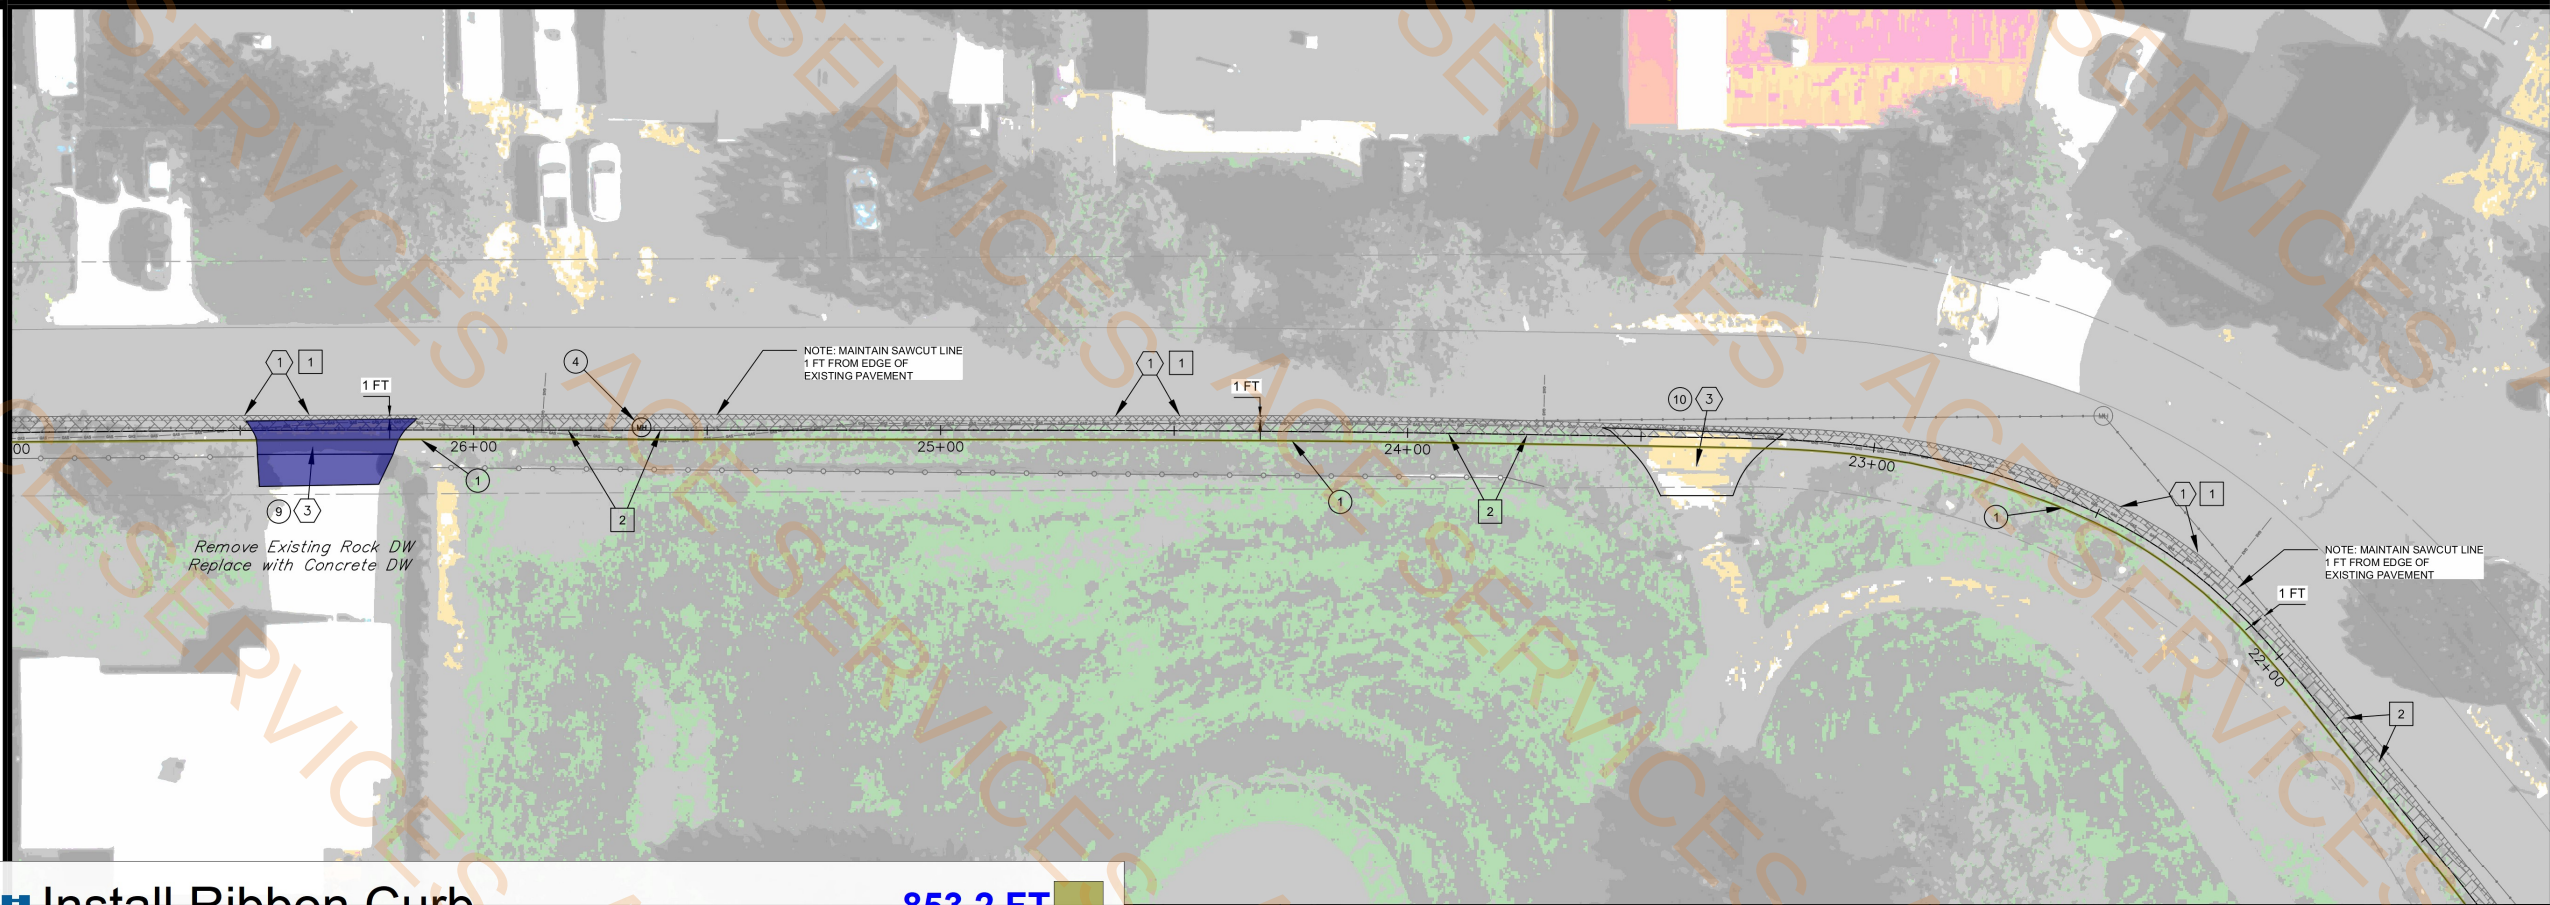

- Install Ribbon Curb
 - Concrete Driveway
 - Traffic Sign Footing
- 853.2 FT
415.0 SQ FT
1.0 EA

DATE PUBLISHED: March 12, 2026
FILE NAME: S:\PW\Secretary\PROJECTS\2. OUT TO BID\5002653 36th Drive Curb\1 CAD\36th Dr Curb.dwg

REMOVAL NOTES

- 1 Remove Asphalt
- 3 Remove Driveway (Asphalt, Concrete, or Rock)

PAVEMENT NOTES

- 1 Install 3" AC Pavement
- 2 Install 3" AC Pavement Over 8" ABC Base

CONSTRUCTION NOTES

- 1 Install Ribbon Curb Per MAG Std Dtl 220 "Type B", See Detail B for Grading
- 4 Raise Existing Manhole
- 6 Relocate Existing Traffic Sign
- 8 Install Stop Bar
- 9 Remove and Replace Concrete Driveway See Detail Note A
- 10 Remove and Replace Asphalt Driveway See Detail Note A

THE CONTRACTOR FOR THE PROJECT SHALL NOT PLACE AND PERMANENT PAVEMENT UNTIL SLEEVING FOR ELECTRIC, GAS, TELEPHONE, CABLE TV, SITE IRRIGATION, OR ANY OTHER UNDERGROUND UTILITY HAS BEEN INSTALLED. IT SHALL BE THE CONTRACTOR'S RESPONSIBILITY TO CONFIRM THAT ALL SLEEVING IS IN PLACE PRIOR TO PLACEMENT OF THE PERMANENT PAVEMENT.



CITY OF SHOW LOW ENGINEERING DIVISION

180 N. 9th Street
Show Low, Arizona 85901
Ph. (928) 532-4080
Fax (928) 532-4009

CONSTRUCTION SHEET

36TH DR CURB ROADWAY IMPROVEMENTS PROJECT

DRN/RTL	DATE: 03/26	SHEET #	SHEET
DES/RTL	DATE: 03/26	10 OF 11	C-3
CHD/RTL	DATE: 03/26		

SEE MATCH LINE STA 29+75



SEE MATCH LINE STA 26+75 SHEET 10

REMOVAL NOTES

- 1 Remove Asphalt
- 2 Remove Existing Culvert/Drainage Pipe
- 3 Remove Driveway (Asphalt, Concrete, or Rock)

PAVEMENT NOTES

- 1 Install 3" AC Pavement
- 2 Install 3" AC Pavement Over 8" ABC Base

CONSTRUCTION NOTES

- 1 Install Ribbon Curb Per MAG Std Dtl 220 "Type B", See Detail B for Grading
- 2 Establish Drainage Ditch
- 9 Remove and Replace Concrete Driveway See Detail Note A
- 11 Remove and Replace Rock Driveway See Detail Note A
- 12 Install 12" CMP Culvert
- 14 Install 18" CMP Culvert
- 17 Install Sloping Concrete Rip Rap See Detail Sheet Note

THE CONTRACTOR FOR THE PROJECT SHALL NOT PLACE AND PERMANENT PAVEMENT UNTIL SLEEVING FOR ELECTRIC, GAS, TELEPHONE, CABLE TV, SITE IRRIGATION, OR ANY OTHER UNDERGROUND UTILITY HAS BEEN INSTALLED. IT SHALL BE THE CONTRACTORS RESPONSIBILITY TO CONFIRM THAT ALL SLEEVING IS IN PLACE PRIOR TO PLACEMENT OF THE PERMANENT PAVEMENT.



CITY OF SHOW LOW ENGINEERING DIVISION

180 N. 9th Street
Show Low, Arizona 85901
Ph. (928) 532-4080
Fax (928) 532-4009

CONSTRUCTION SHEET

36TH DR CURB ROADWAY IMPROVEMENTS PROJECT

DRN/RTL	DATE: 03/26	SHEET #	SHEET
DES/RTL	DATE: 03/26	11 OF 11	C-4
CHD/RTL	DATE: 03/26		

Install Ribbon Curb

Concrete Driveway

Concrete Rip rap

Deep Turndown in Concrete Rip Rap

678.9 FT

252.2 SQ FT

68.5 SQ FT

32.0 FT

