

**DEFENSE LOGISTICS AGENCY
INSTALLATION MANAGEMENT
SAN JOAQUIN, DM-FJIF**

MISSION ESSENTIAL PROJECTS

PROJECT # P.2025.00785

APPENDIX A

**Conceptual Modular and
Layout Drawings**



INTERIOR LAYOUT


Wall Outlet under Desks
Each Wall Plate/Outlet is a 2 Way

2'x4' Ceiling Tiles on T-bars

Wall Mounted HVAC

271.6 SQ FT

1.0 EA

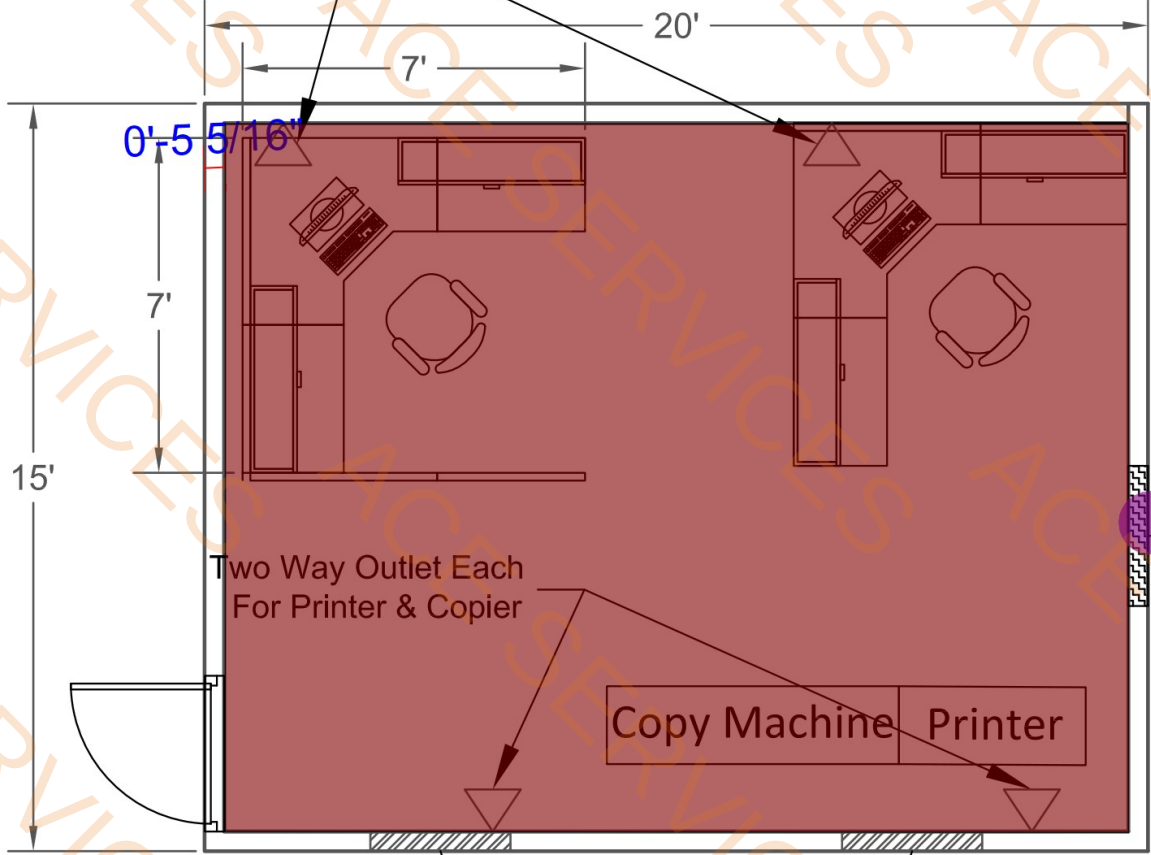

Wall Mount HVAC

36"X36" Windows

Copy Machine Printer


Two Way Outlet Each
For Printer & Copier

- Notes**
- Two windows installed on side facing into the warehouse no less than 36"x36"
 - Cubicle walls will be 60" tall
 - All doors are 36" in width and open to the exterior
 - Single story two cubicle furniture layout

GRAPHIC SCALE			
0 3' 6' 9'			
Revision two 08/13/2025 Single Story Modular Office			
DESIGNED BY:	AG		AG
DRAWN BY:	AG		
CHECKED:			
DEFENSE LOGISTICS AGENCY (DLA) DLA INSTALLATION SUPPORT AT SAN JOAQUIN FACILITIES & EQUIPMENT ENGINEERING BRANCH			
DEFENSE DISTRIBUTION DEPOT SAN JOAQUIN SITE			
WHSE17_SEC4-2 MODULAR_OFFICE			
PROJECT NO:	P.2025.00785		
SCALE:	N.T.S.	DATE:	08-13-2025
DRAWING FILE NAME:	SINGLESTORYMODOFF		E-1 1 OF 1
SHEET:	B		

INTERIOR LAYOUT

Wall Outlet under Desks
Each Wall Plate/Outlet is a 2 Way

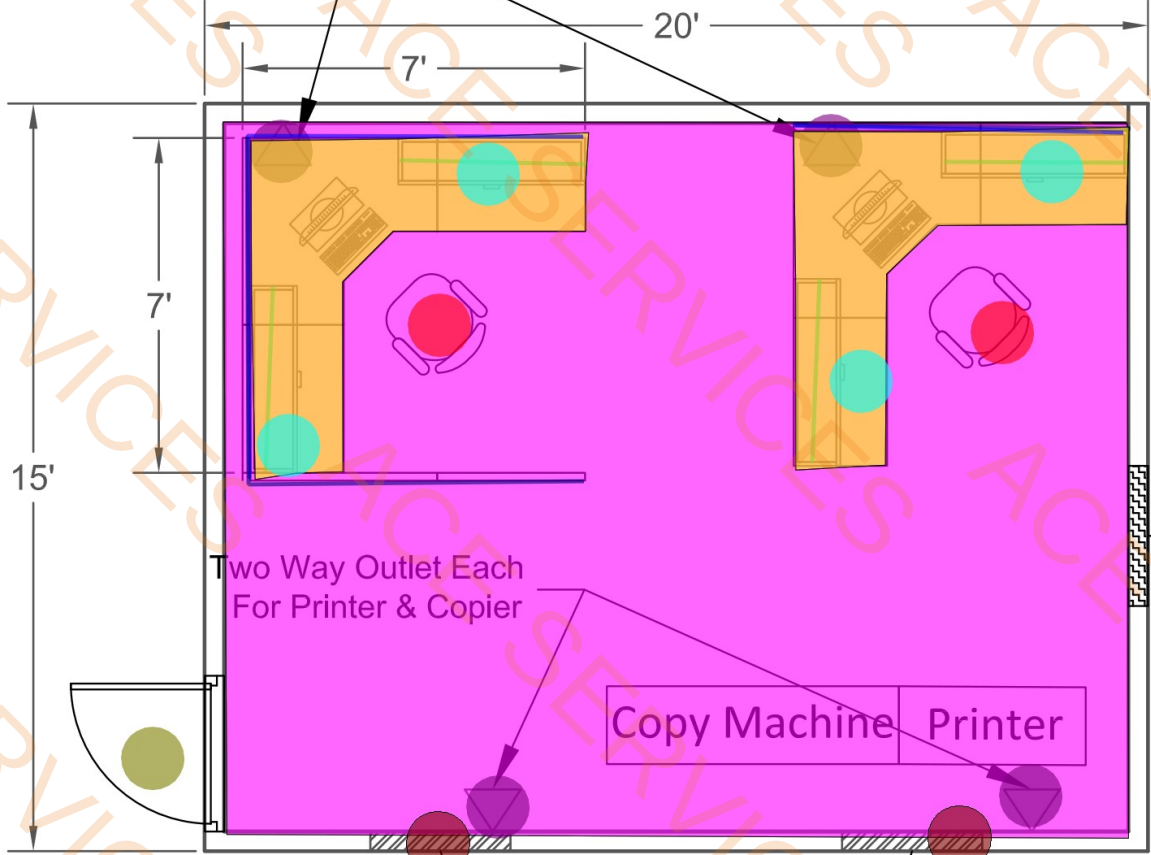

- Epoxy Coating on Concrete Floor 273.6 SQ FT
- Cubicle Wall 60" Ht 21.2 FT
- Two-Way Outlet 4.0 EA
- 18" Deep and 65" Ht Cabinets 15.3 FT
- Ergonomic office chairs 2.0 EA
- 2'-0" D Work Surface 46.4 SQ FT
- Metal Frame Panel 64" High 21.0 FT
- 18" Deep by 65" High and 42" Wide Cabinets 4.0 EA
- Pre-Finish Door 1.0 EA
- 36"x 36" Window 2.0 EA

Wall Mount HVAC

36"X36" Windows


Copy Machine Printer

Two Way Outlet Each
For Printer & Copier


Notes

- Two windows installed on side facing into the warehouse no less than 36"x36"
- Cubicle walls will be 60" tall
- All doors are 36" in width and open to the exterior
- Single story two cubicle furniture layout

GRAPHIC SCALE

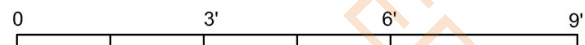


DESIGNED BY:	AG	DEFENSE LOGISTICS AGENCY (DLA)
DRAWN BY:	AG	DLA INSTALLATION SUPPORT AT SAN JOAQUIN
CHECKED:		FACILITIES & EQUIPMENT ENGINEERING BRANCH
SPECIFICATION NO:		
PROJECT NO:	P.2025.00785	DEFENSE DISTRIBUTION DEPOT SAN JOAQUIN
SCALE:	N.T.S.	SITE
DATE:	08-13-2025	WHSE17_SEC4-2
DRAWING FILE NAME:	SINGLESTORYMODOFF	MODULAR_OFFICE
SHEET:	1 OF 1	
SIZE:	B	

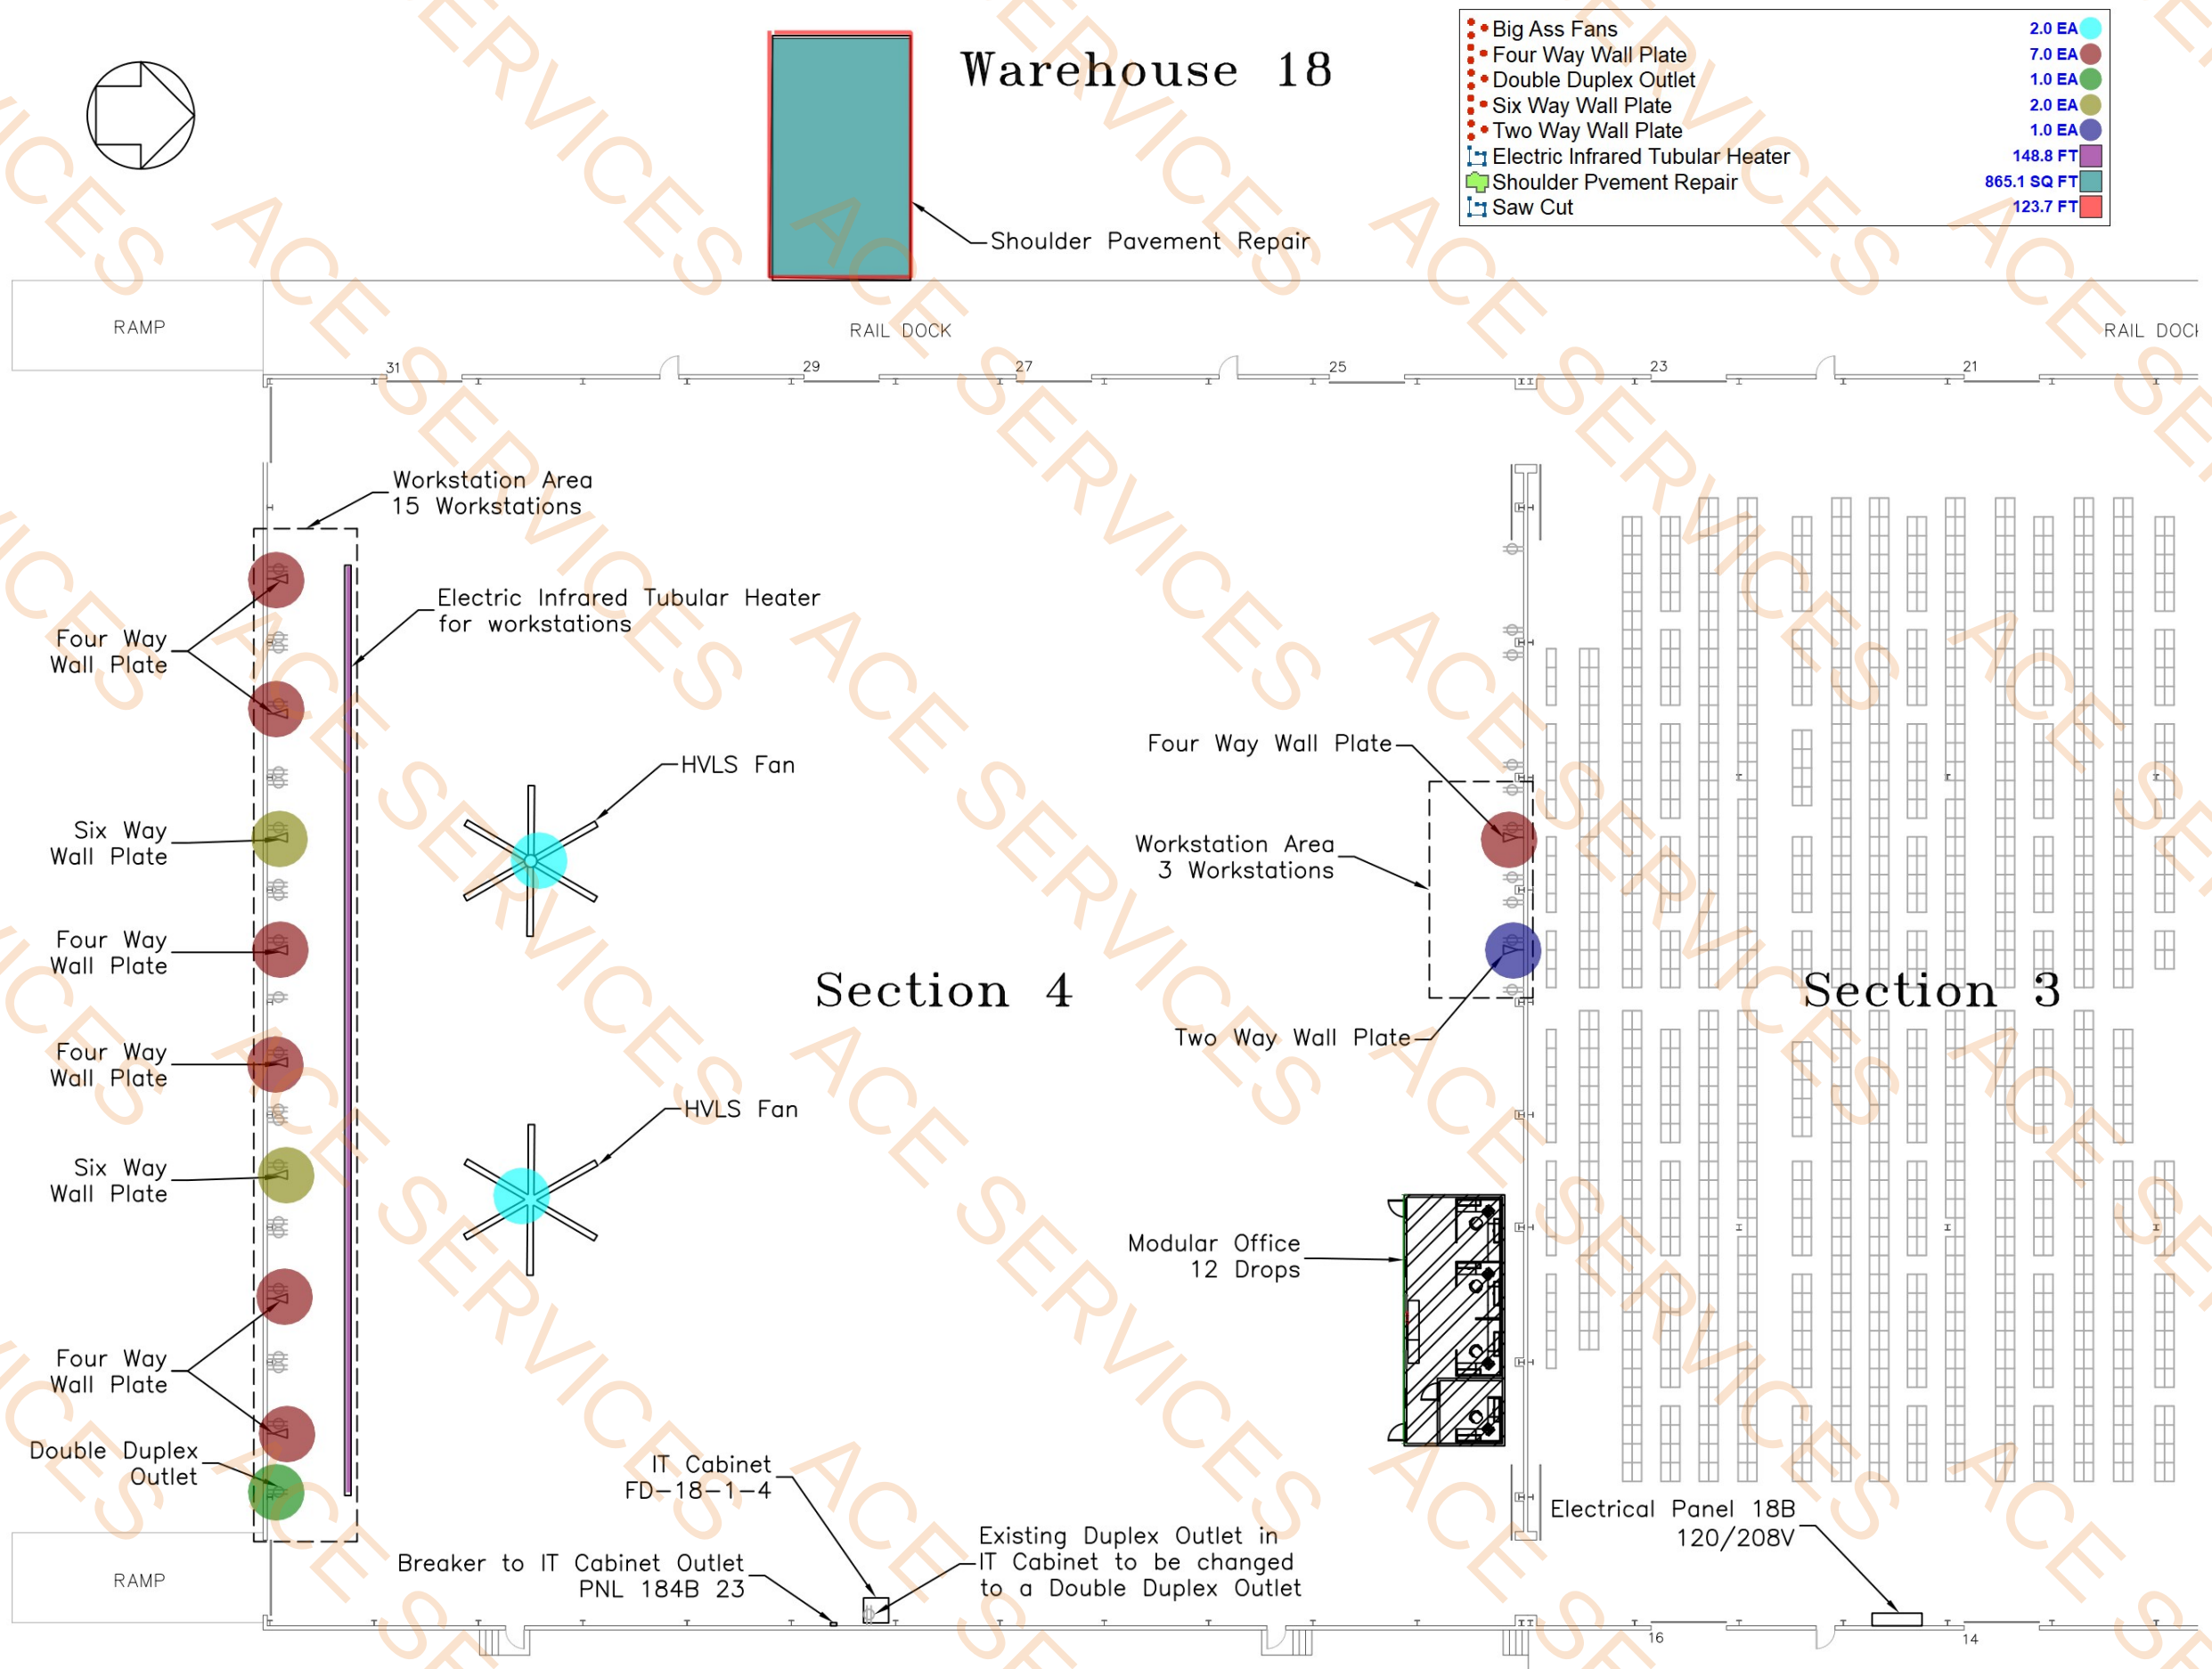

INTERIOR LAYOUT

Wall Outlet under Desks
Each Wall Plate/Outlet is a 2 Way

Wall Outlet under Desks
Each Wall Plate/Outlet is a 2 Way

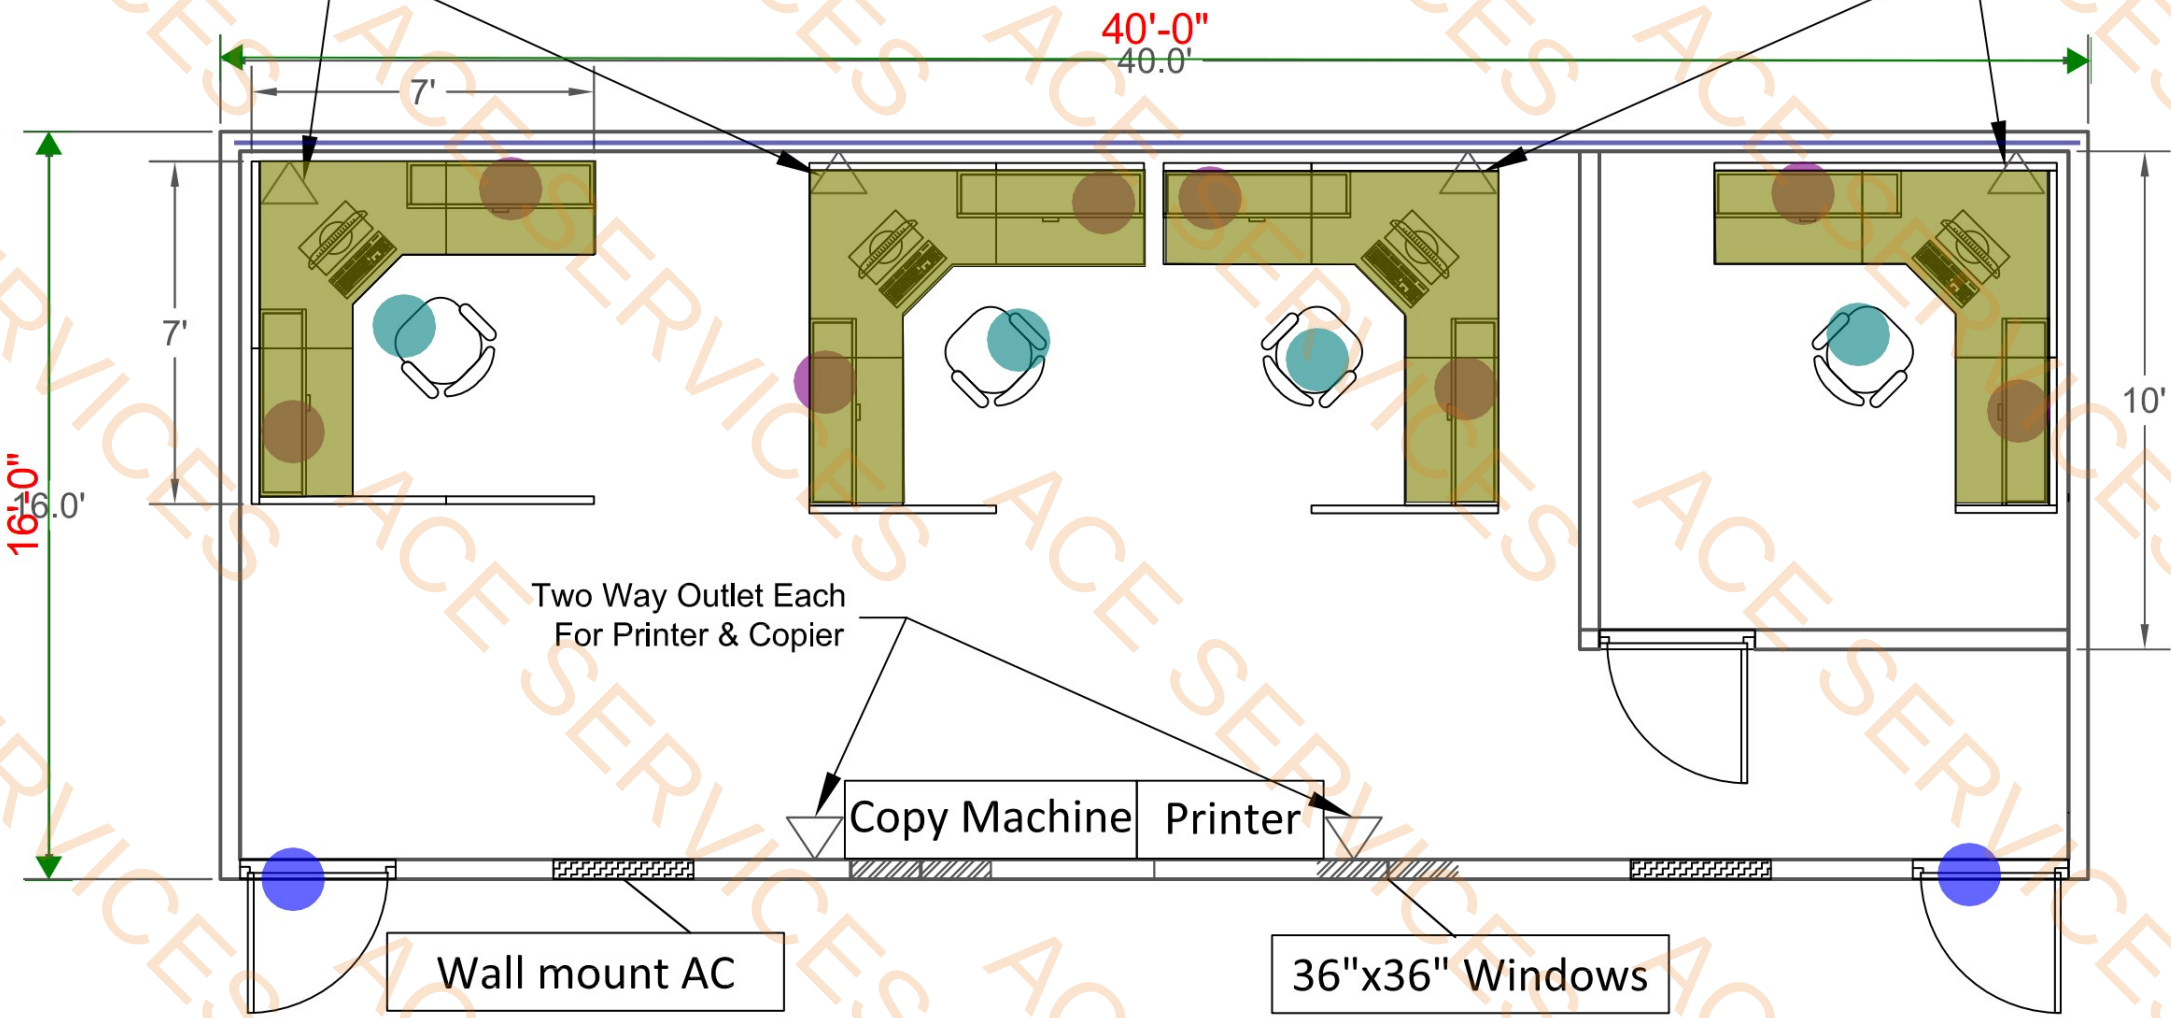

- 24" D Wood Work Surface w/Utility Drawers 99.9 SQ FT
- 64"H Metal Frame Wall Panel 39.5 FT
- 1'D x 4'L Full Height Shelves 8.0 EA
- Office Chairs 4.0 EA
- Exterior Lights 2.0 EA

GRAPHIC SCALE	
0 3' 6' 9'	
Revision one 04/02/2025 Single Story Mod Office	
DESIGNED BY: AG	DEFENSE LOGISTICS AGENCY (DLA) DLA INSTALLATION SUPPORT AT SAN JOAQUIN FACILITIES & EQUIPMENT ENGINEERING BRANCH
DRAWN BY: AG	DEFENSE DISTRIBUTION DEPOT SAN JOAQUIN SITE
CHECKED:	WHSE18_SEC4 MODULAR_OFFICE
SPECIFICATION NO:	SUBMITTED BY:
PROJECT NO: P.2025.00785	APPROVED BY:
SCALE: N.T.S.	DATE: 04/02/2025
DRAWING FILE NAME: SINGLESTORYMODOFF	SHEET: E-1 1 OF 1
SIZE: B	

