


DONNIE BICKHAM NEW CLASSROOM WING ADDITION

7240 OLD MOORINGSPO RT RD
SHREVEPORT, LA 71107

CPSB PROJECT NO.: 2026-101
TBA PROJECT NO.: 25-BC0021

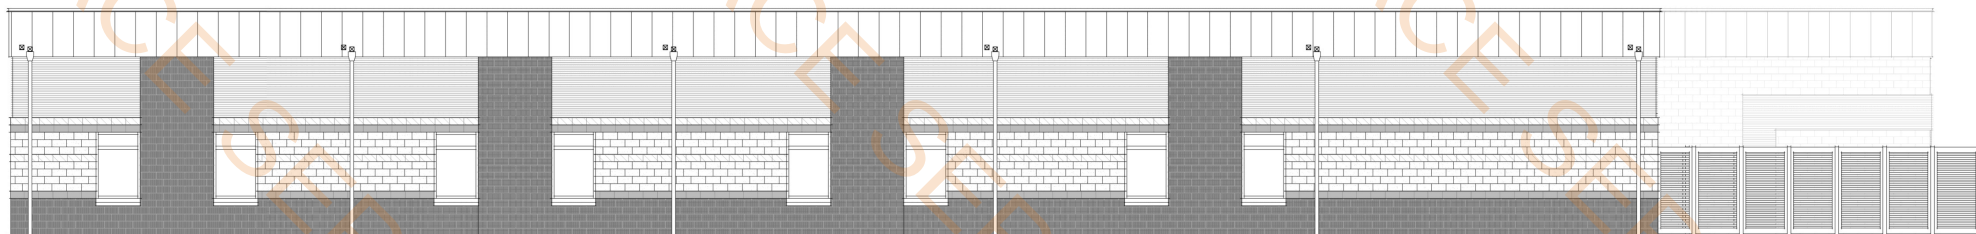

OWNER

CADDO PARISH SCHOOL BOARD
1961 MIDWAY AVENUE
SHREVEPORT, LA 71108

KEITH S. BURTON
SUPERINTENDENT OF SCHOOLS
CADDO PARISH SCHOOL SYSTEM

STEVE WHITE
CONSTRUCTION AND CAPITAL PROJECTS
CADDO PARISH SCHOOL SYSTEM

CADDO PARISH SCHOOL BOARD MEMBERS

STEVE UMLING	DISTRICT 1	JERRY BOWMAN, JR.	DISTRICT 7
JASMINE GREEN	DISTRICT 2	CHRISTINE THARPE	DISTRICT 8
DR. TERENCE VINSON	DISTRICT 3	BARRY F. RACHAL	DISTRICT 9
DON LITTLE	DISTRICT 4	KATIE MCLAIN	DISTRICT 10
DR. BONITA DOUZART	DISTRICT 5	JESSICA YEATES	DISTRICT 11
MARY TRAMMEL	DISTRICT 6	DOTTIE BELL	DISTRICT 12

CIVIL ENGINEER

COYLE ENGINEERING CO., INC.
3925 BENTON RD
BOSSIER CITY, LA 71171
PHONE: 318-746-8987

ARCHITECT

TBA


2250 HOSPITAL DR, SUITE 100
BOSSIER CITY, LA 71111
PHONE: 318-742-4675

MEP ENGINEER

EMA ENGINEERING & CONSULTING, INC.
9441 STEVENS RD, SUITE 200
SHREVEPORT, LA 71106
PHONE: 318-425-4500

STRUCTURAL ENGINEER

AILLET, FENNER, JOLLY, & MCCLELLAND INC.
3003 KNIGHT ST
SHREVEPORT, LA 71105
PHONE: 318-425-7452

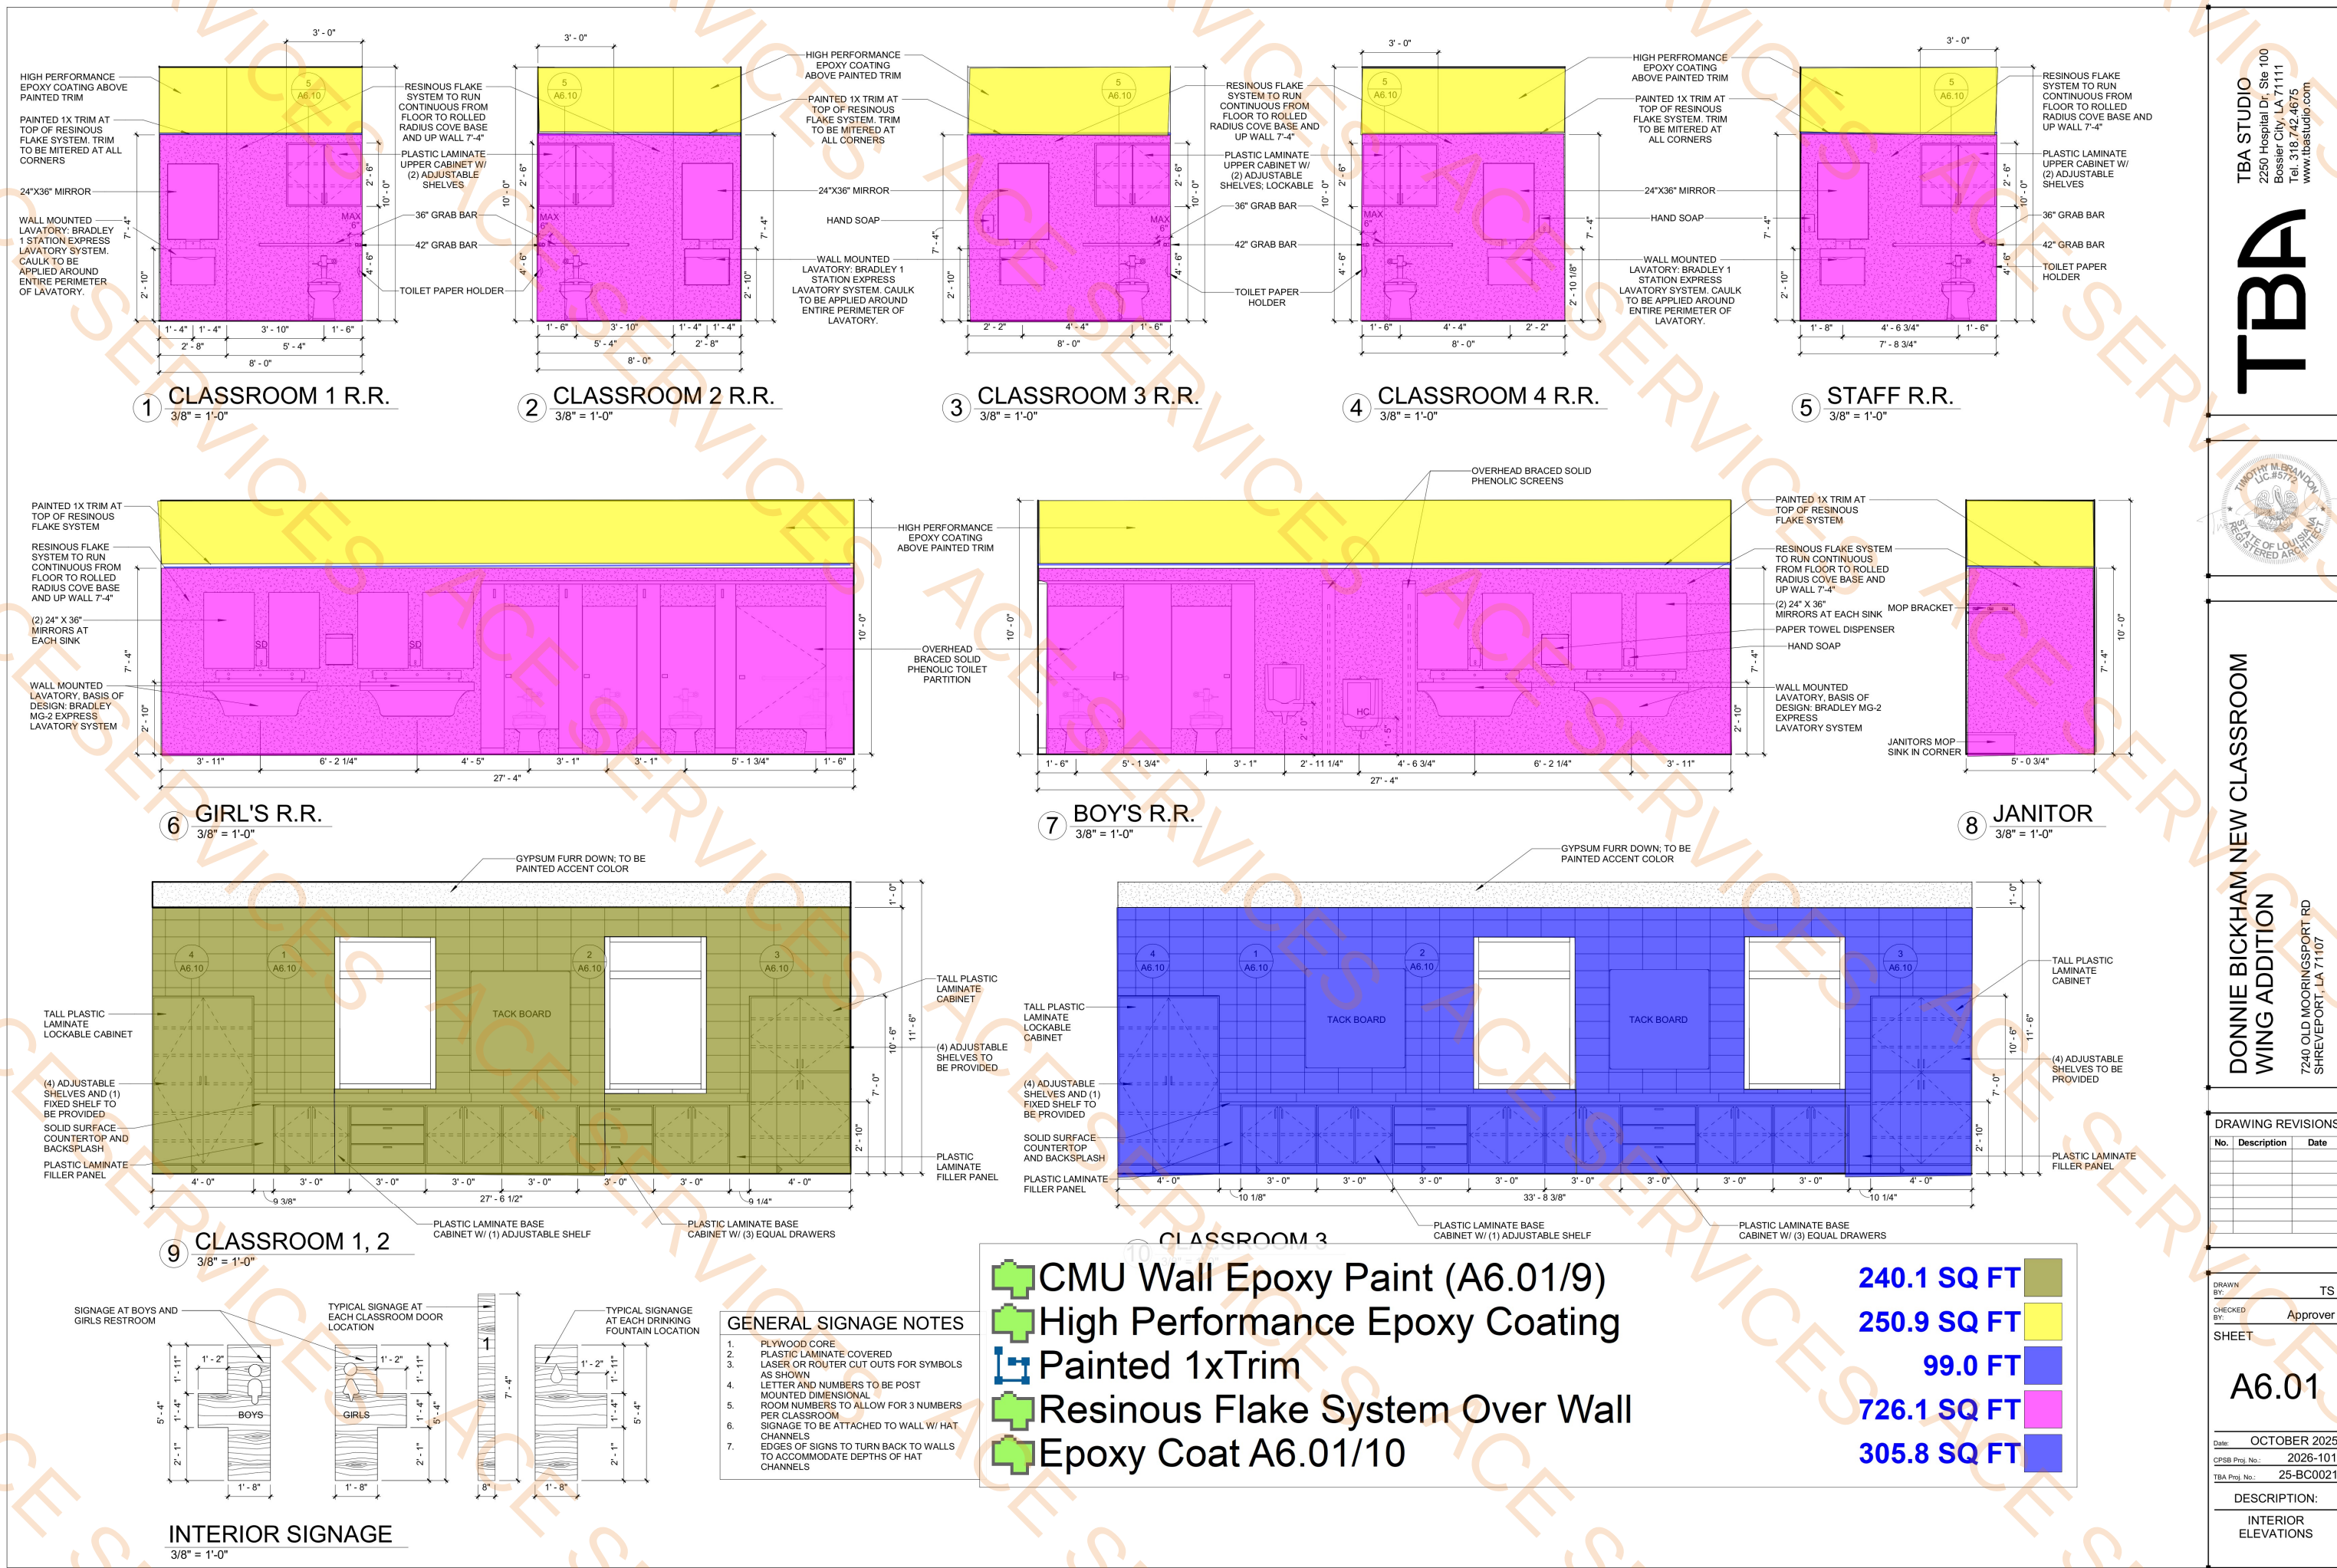

TBA STUDIO
2250 Hospital Dr. Ste 100
Bossier City, LA 71111
Tel. 318.742.4675
www.tbastudio.com

DONNIE BICKHAM NEW CLASSROOM
WING ADDITION
7240 OLD MOORINGSPOUR RD
SHREVEPORT, LA 71107

DRAWING REVISIONS		
No.	Description	Date

DRAWN BY: TS


CHECKED BY: Approver

SHEET


A6.01

OCTOBER 2025
CPSB Proj. No.: 2026-101
TBA Proj. No.: 25-BC0021


DESCRIPTION:
INTERIOR
ELEVATIONS

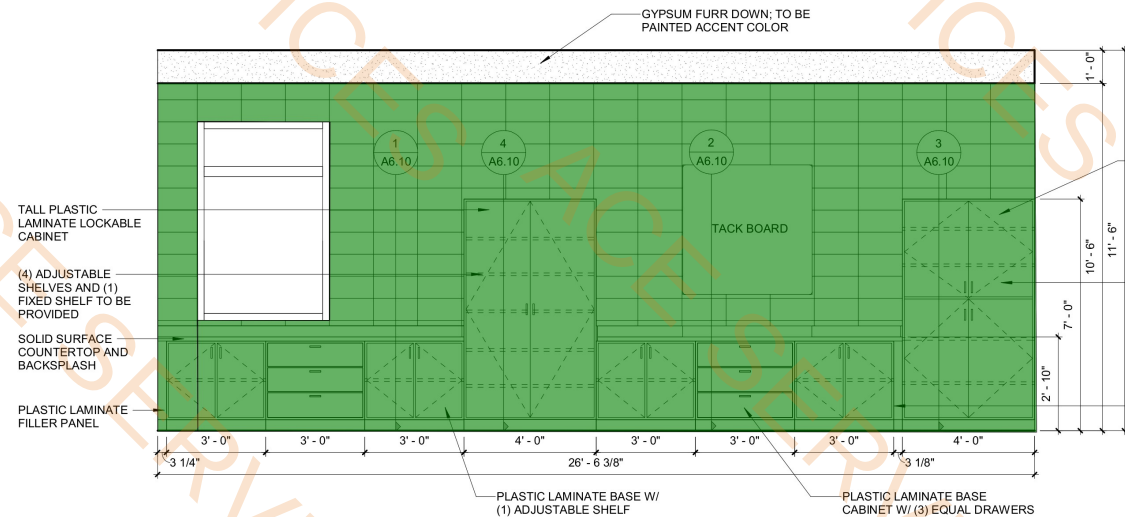


1 CLASSROOM 4
3/8" = 1'-0"

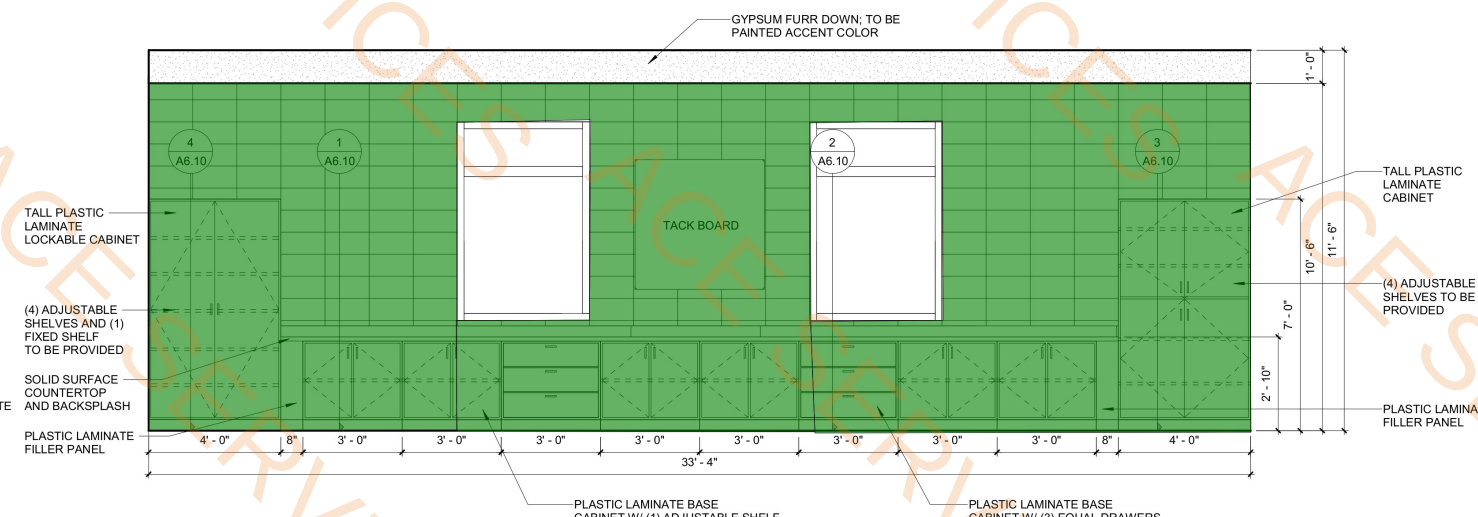


2 CLASSROOM 5
3/8" = 1'-0"

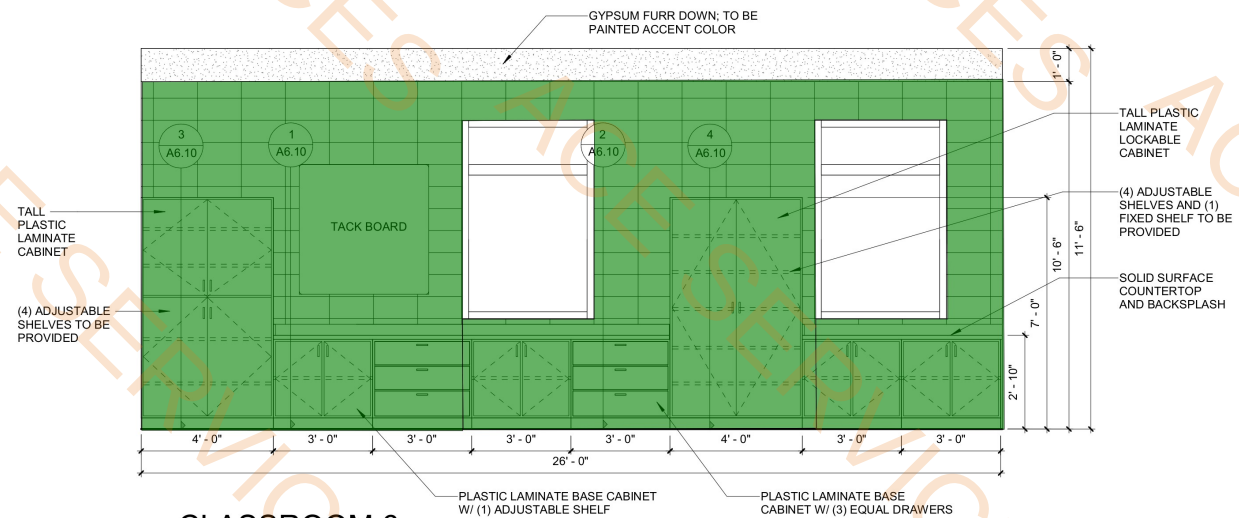

3 CLASSROOM 6
3/8" = 1'-0"

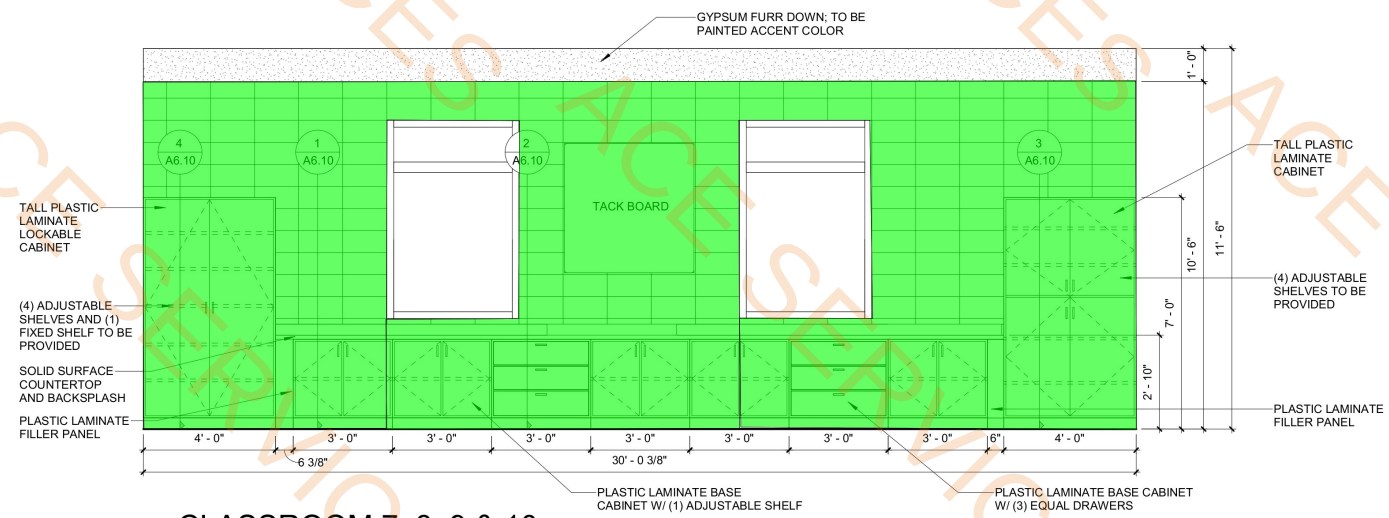


4 CLASSROOM 7, 8, 9 & 10
3/8" = 1'-0"

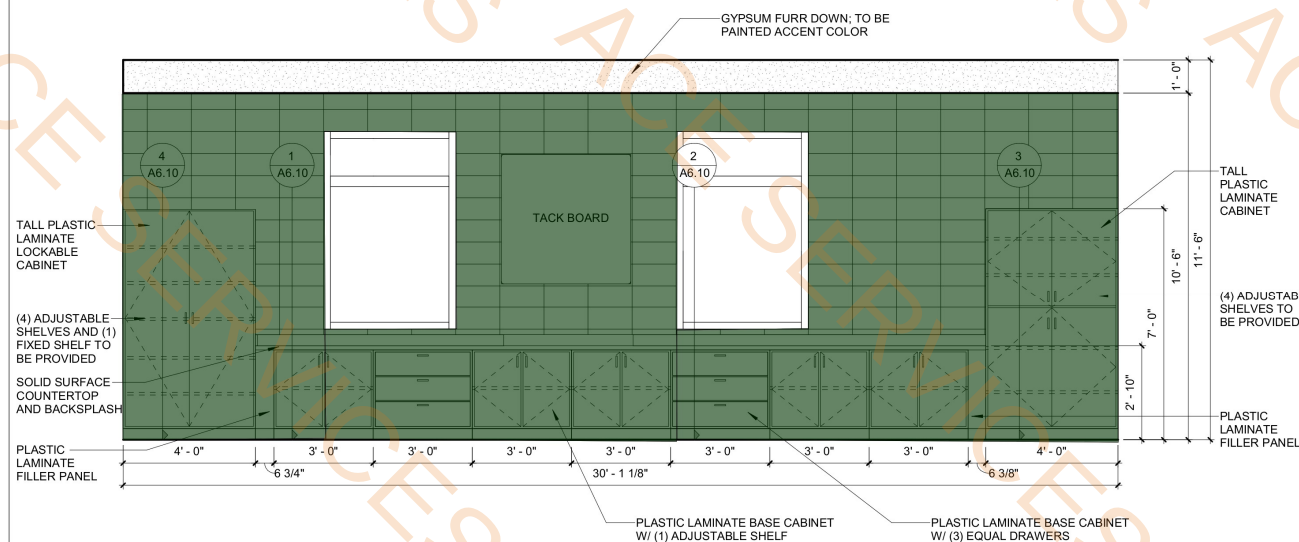

5 CLASSROOM 11 & 12
3/8" = 1'-0"

- CMU Wall Epoxy Paint (A6.02/2) (A6.02/1) (A6.02/3)
- CMU Wall Epoxy Painted Section (A6.02/4)
- High Performance Epoxy Coating
- Epoxy Coating (A6.02/5)

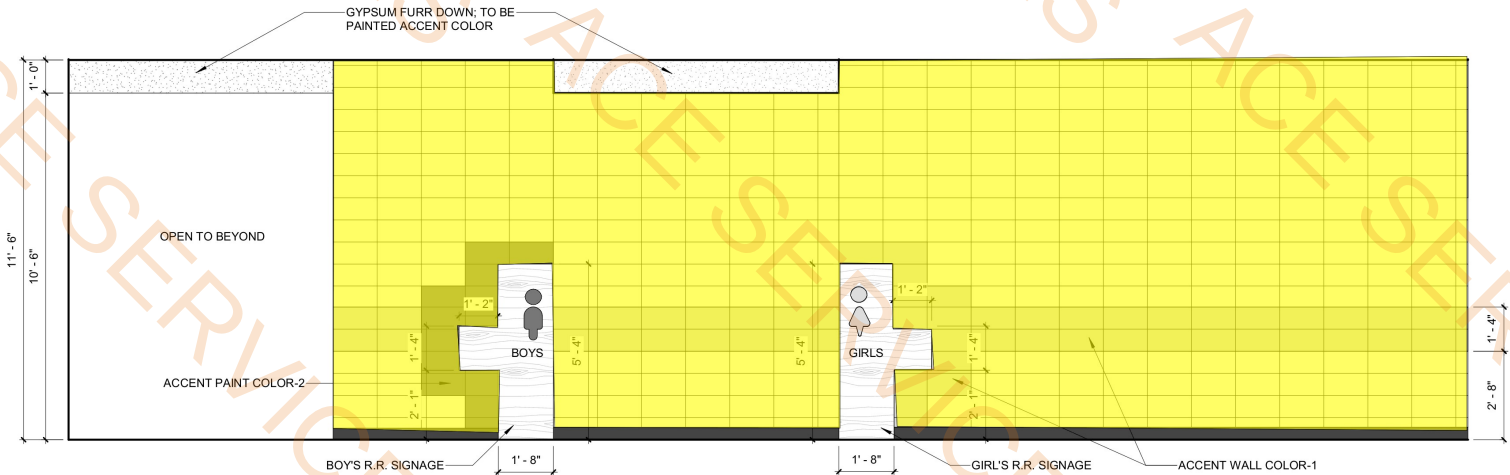


6 CORRIDOR 114
3/8" = 1'-0"

- 784.2 SQ FT
- 266.7 SQ FT
- 354.9 SQ FT
- 268.4 SQ FT

TBA STUDIO
2250 Hospital Dr. Ste 100
Bossier City, LA 71111
Tel. 318.742.4675
www.tbastudio.com

TBA

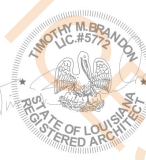

DONNIE BICKHAM NEW CLASSROOM
WING ADDITION
7240 OLD MOORINGSPOUR RD
SHREVEPORT, LA 71107

DRAWING REVISIONS

No.	Description	Date

DRAWN BY: TS
CHECKED BY: Approver
SHEET

A6.02

Date: OCTOBER 2025
CPSB Proj. No.: 2026-101
TBA Proj. No.: 25-BC0021

DESCRIPTION:
INTERIOR
ELEVATIONS

- Painted 5/8" Gypsum Board Ceiling
- Painted 5/8" Gypsum Board Ceiling Soffit (1'-0" Ht)
- Paint At Exposed Ceiling
- Paint @ Metal Soffit Panel

1807.4 SQ FT
453.2 FT
649.9 SQ FT
483.1 SQ FT

CEILING MATERIAL LEGEND

	2'-0" x 2'-0" CEILING TILES AND SUSPENDED METAL GRID	ACT-1
	2' X 2' MOISTURE RESISTANT ACOUSTICAL CEILING TILE - SEE SPECIFICATIONS	ACT-2
	GYPSUM BOARD CEILING	GYP-1
	METAL SOFFIT PANEL	SOF-1
	0'-0" C.H.	CEILING HEIGHT

1. THE REFLECTED CEILING PLAN DRAWING INDICATES CEILING FINISHES AND HEIGHTS. SEE ELECTRICAL DRAWINGS FOR ALL LIGHTING AND CEILING MOUNTED DEVICES WHICH SHALL BE COUNTED AND INSTALLED PER THE ELECTRICAL DRAWINGS. ALL SUSPENDED ACOUSTIC CEILINGS IN CORRIDORS SHALL HAVE HOLD DOWN CLIPS. SEE THE FINISH SCHEDULE FOR MORE INFORMATION ON THE SPECIFIC TYPE OF CEILING TILES AND FINISHES FOR EACH INDIVIDUAL ROOM.

2. THE ARCHITECT MAINTAINS THE RIGHT TO SELECT LIGHT FIXTURE, ELECTRICAL SWITCH, OUTLET, AND ALL COVER PLATES COLOR. IF THE COLOR IS INCLUDED IN THE ELECTRICAL SPECIFICATIONS OR THE SUBMITTAL, AND APPROVED BY THE ELECTRICAL ENGINEER, THE ARCHITECT SHALL STILL APPROVE ALL COLORS BEFORE THAT SUBMITTAL ITEM IS CONSIDERED OFFICIAL.

TBA STUDIO
2250 Hospital Dr. Ste 100
Bossier City, LA 71111
Tel. 318.742.4675
www.tbastudio.com

TBA



DONNIE BICKHAM NEW CLASSROOM
WING ADDITION
7240 OLD MOORINGSPORT RD
SHREVEPORT, LA 71107

DRAWING REVISIONS

No.	Description	Date

DRAWN BY: TS
CHECKED BY: Approver
SHEET

A7.01

Date: OCTOBER 2025
CPSB Proj. No.: 2026-101
TBA Proj. No.: 25-BC0021

DESCRIPTION:
REFLECTED
CEILING PLAN



Resinous Flake System Flooring
Sealed Concrete Flooring
8" High RFS Wall Base

947.7 SQ FT
593.3 SQ FT
336.4 FT

FLOOR PLAN LEGEND

- VCT-1 - VINYL COMPOSITION TILE, COLOR #1
- VCT-2 - VINYL COMPOSITION TILE, COLOR #2
- VCT-3 - VINYL COMPOSITION TILE, COLOR #3
- RFS - RESINOUS FLAKE SYSTEM
- SEALED CONCRETE
- TH - THRESHOLD
- TS - TRANSITION STRIP
- FD - FLOOR DRAIN, SEE PLUMBING PLANS FOR MORE INFORMATION

TBA STUDIO
2250 Hospital Dr. Ste 100
Bossier City, LA 71111
Tel. 318.742.4675
www.tbastudio.com

TBA



DONNIE BICKHAM NEW CLASSROOM
WING ADDITION
7240 OLD MOORINGSPOUR RD
SHREVEPORT, LA 71107

DRAWING REVISIONS

No.	Description	Date

DRAWN BY: TS
CHECKED BY: Approver
SHEET

A8.01

Date: OCTOBER 2025
CPSB Proj. No.: 2026-101
TBA Proj. No.: 25-BC0021

DESCRIPTION:
FLOOR PATTERN
PLAN