

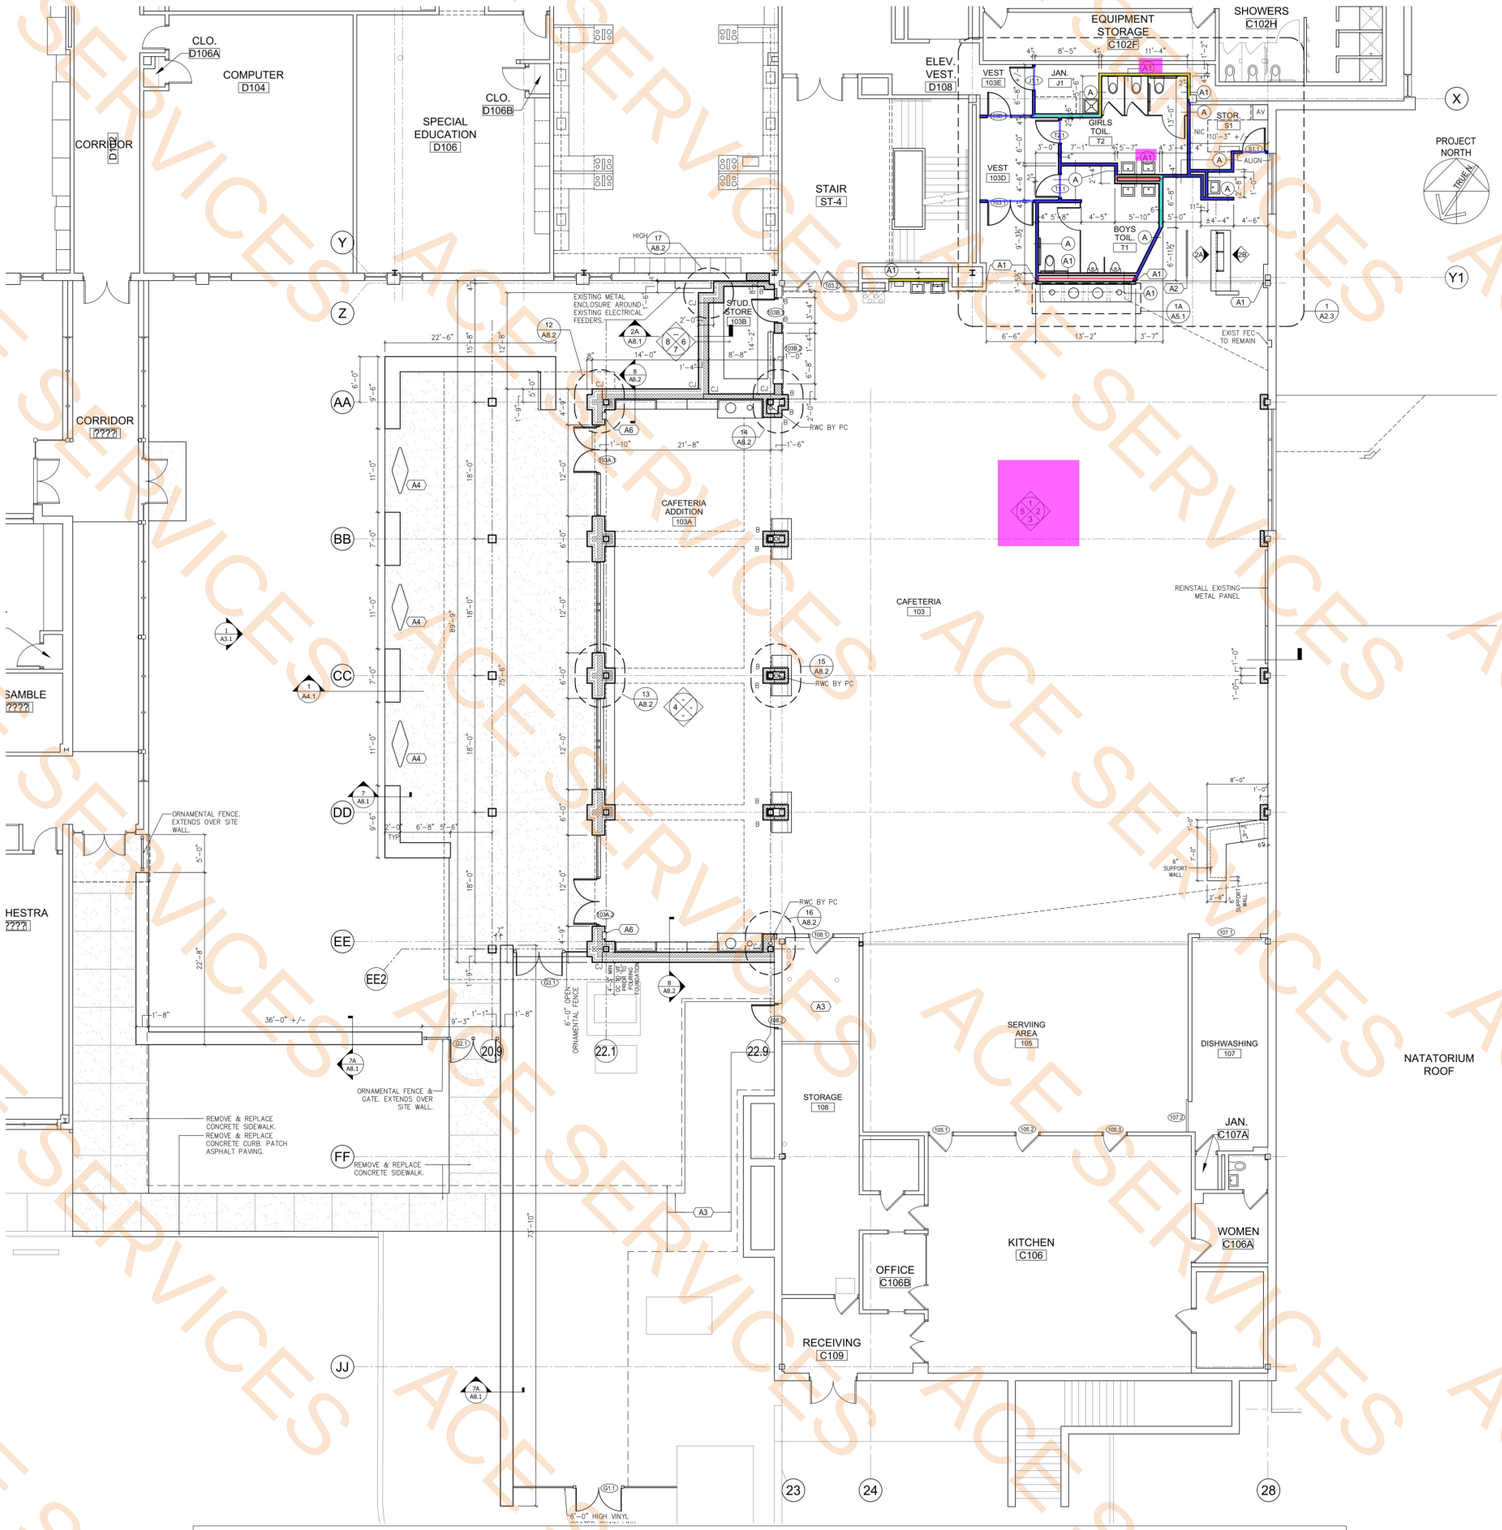


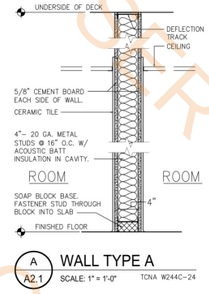

A A2.1 WALL TYPE A
SCALE: 1" = 1'-0" TCNA W244C–24

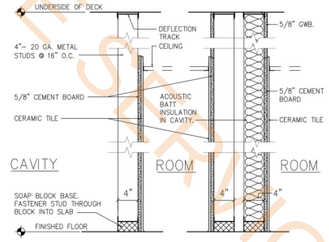

A1 A2.1 WALL TYPE A1
SCALE: 1" = 1'-0" TCNA W244C–24

PLAN SYMBOLS

- ROOM NAME / ROOM NUMBER
- DETAIL NUMBER / SHEET NUMBER
- SECTION DETAIL NUMBER / SHEET NUMBER / DIRECTIONAL VIEW
- INTERIOR ELEV. TAG (MULTIPLE VIEW)
- INTERIOR ELEV. TAG (SINGLE VIEW)
- DOOR NUMBER (REFER TO DOOR SCHEDULE)
- EXISTING TO REMAIN, TYP.
- DEMOLITION
- NEW MTL STUD WALL
- NEW MASONRY WALL
- DEMOLISH EXISTING DOOR

FLOOR PLAN GENERAL NOTES:


GENERAL NOTES SHALL BE APPLICABLE FOR ALL PROJECT LOCATIONS. WHEN THE WORK INDICATED IS RELEVANT

1. REFER TO SHEET A-0.1 FOR COMMON ABBREVIATIONS.
2. ALL DIMENSIONS ARE TO FACE OF FINISHED WALL, UNLESS NOTED OTHERWISE (U.N.O.).
3. SEE CODE DRAWINGS FOR LOCATIONS OF FIRE RATED WALLS.
4. CONTRACTOR SHALL COORDINATE TIMING OF ALL WORK WITH OTHER DISTRICT CONSULTANTS PRIOR TO STARTING WORK., AS REQUIRED.
5. PAINT ALL NEW AND EXISTING PIPING, CONDUIT, ETC. WHERE EXPOSED TO MATCH ADJACENT WALL/CEILING SURFACES AT ALL NEWLY PAINTED SURFACES.
6. REFERENCE INTERIOR ELEVATIONS FOR NEW WORK DETAILS AS INDICATED.
7. PAINT ALL WALL INFILLS THE SAME COLOR AS ADJACENT WALLS UNO

(A##)	FLOOR PLAN - KEYNOTES
A1	1" WALL EXPANSION JOINT.
A2	SS HANDRAIL. PROVIDE BASE PLATE ON BOTTOM OF VERITICAL POST & THROUGH BOLT THROUGH SLAB WITH PLATE ON UNDERSIDE OF SLAB.
A3	SEE PHASING PLAN FOR TEMPORARY EGRESS NOTES
A4	EXTERIOR CONCRETE PLANTER. MODEL ZB.DP.02 LARGE DRIP BY WAUSAU TILE. ARCHITECT TO SELECT COLOR FROM FULL RANGE OF STANDARD OPTIONS: https://wausautile.com/Products/Large-Drip-Planter-ZBDP02_1.cfm
A5	NOT USED
A6	FIRE EXTINGUISHER CABINET

(A) 3-5/8" Metal Wall Studs @ 16" O.C (20 DA) — 104.9 FT
(A) 6" Metal Wall Studs @ 16" O.C (20 DA) — 15.5 FT
(A1 - One Side) 5-5/8" Metal Wall Studs @ 16" O.C (20 DA) — 28.3 FT
(A1 - Double Side) 5-5/8" Metal Wall Studs @ 16" O.C (20 DA) — 19.6 FT

1 A2.1 FLOOR PLAN
SCALE: 1/8" = 1'-0"

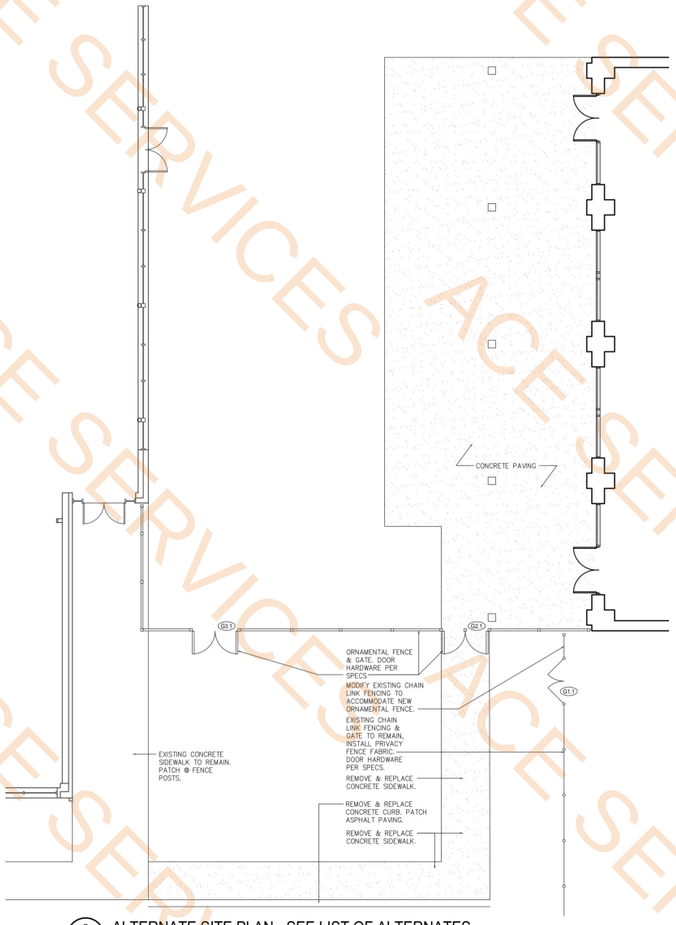

2 A2.1 ALTERNATE SITE PLAN - SEE LIST OF ALTERNATES
SCALE: 1/8" = 1'-0"

GODSHALL KANE O'ROURKE ARCHITECTS, LLC
300 Brookside Avenue
Ambler Yards - Building 18 - Suite 150
Ambler, PA 19002
T: 215.646.2003 www.gkoarchitects.com

GKO ARCHITECTS

ROSE TREE MEDIA SCHOOL DISTRICT
SPRINGTON LAKE MIDDLE SCHOOL
CAFETERIA ADDITION & RENOVATION
1900 N. PROVIDENCE ROAD, MEDIA, PA. 19063

REVISIONS	
DRAWN BY	LL
REVIEWED	KG
JOB #	2544

SHEET TITLE


FLOOR PLAN

SHEET #


A2.1

SCALE	AS NOTED
DATE	1-9-2025

ACE SERVICES

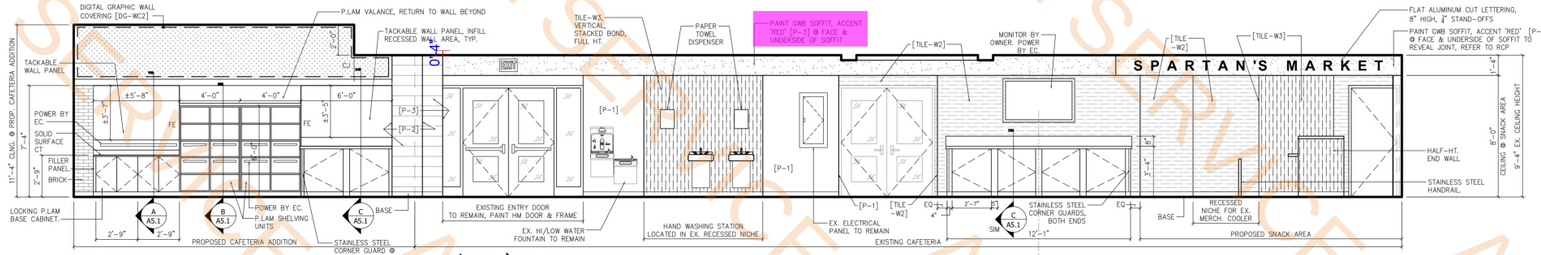


1 A5.1 INTERIOR ELEVATION
SCALE: 1/4" = 1'-0"

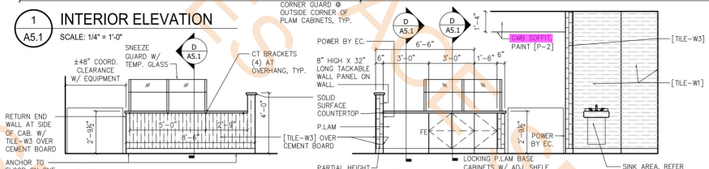


2A A5.1 INTERIOR ELEVATION
SCALE: 1/4" = 1'-0"


2B A5.1 INTERIOR ELEVATION
SCALE: 1/4" = 1'-0"

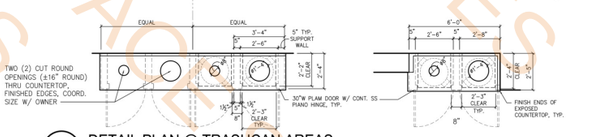


1A A5.1 DETAIL PLAN @ TRASHCAN AREAS
SCALE: 1/4" = 1'-0"

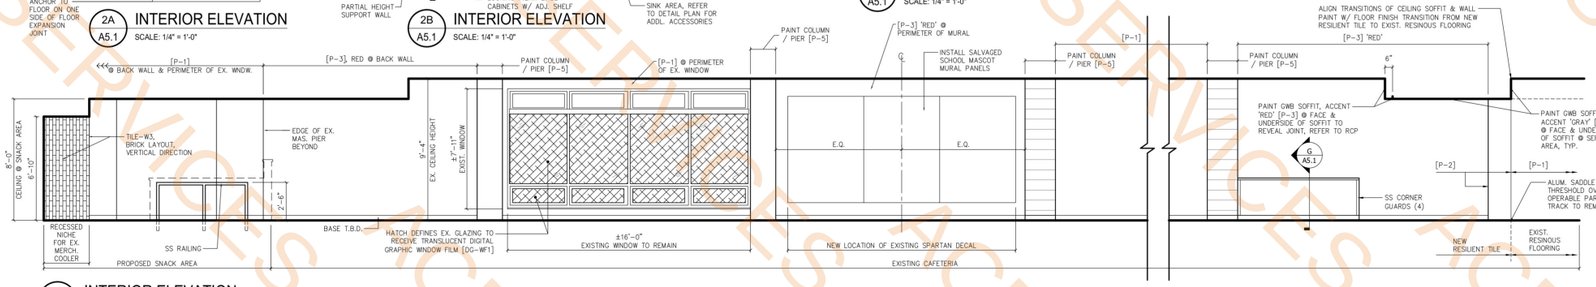


2 A5.1 INTERIOR ELEVATION
SCALE: 1/4" = 1'-0"

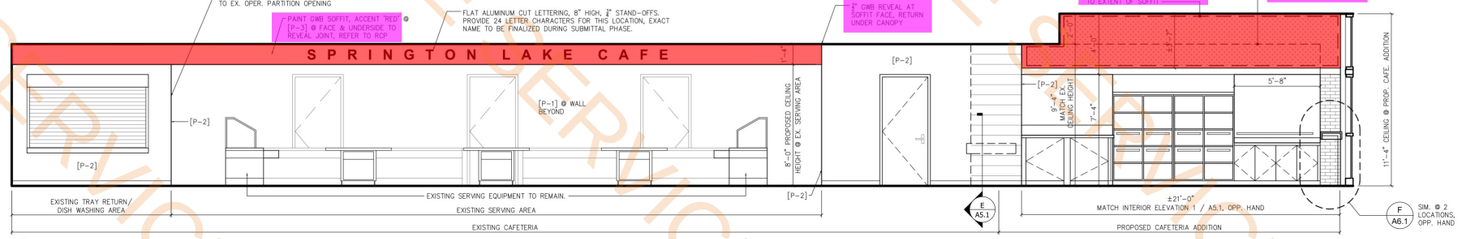

3 A5.1 INTERIOR ELEVATION
SCALE: 1/4" = 1'-0"

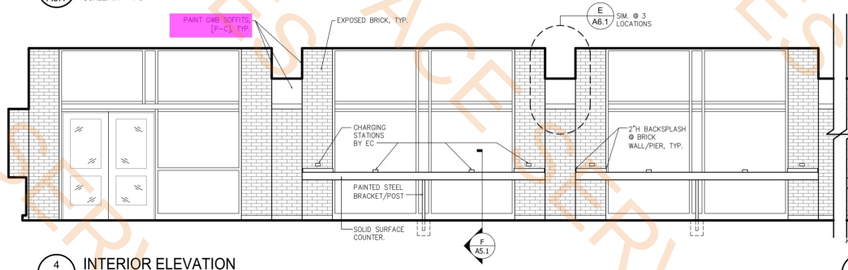


4 A5.1 INTERIOR ELEVATION
SCALE: 1/4" = 1'-0"

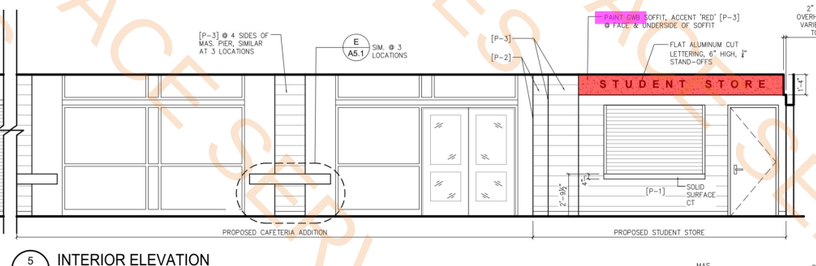

5 A5.1 INTERIOR ELEVATION
SCALE: 1/4" = 1'-0"


Painted GWB @ Ceiling **158.8 SQ FT**

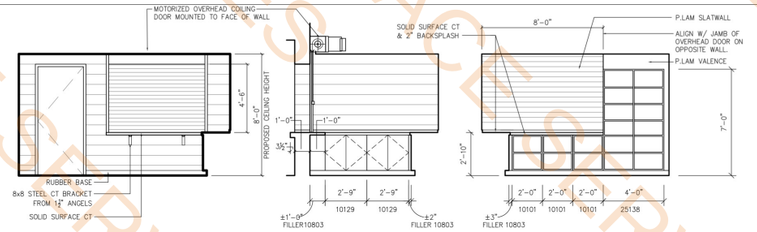


6 A5.1 STUDENT STORE
SCALE: 1/4" = 1'-0"

7 A5.1 STUDENT STORE
SCALE: 1/4" = 1'-0"


8 A5.1 STUDENT STORE
SCALE: 1/4" = 1'-0"

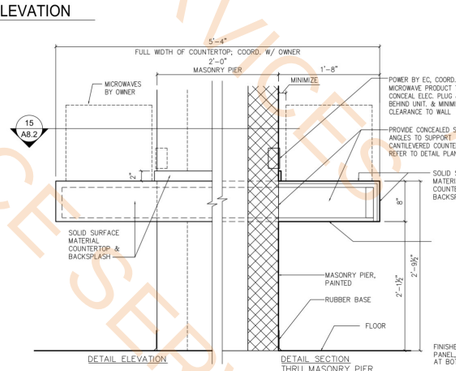


E A5.1 MICROWAVE SHELF DETAIL
SCALE: 1" = 1'-0"

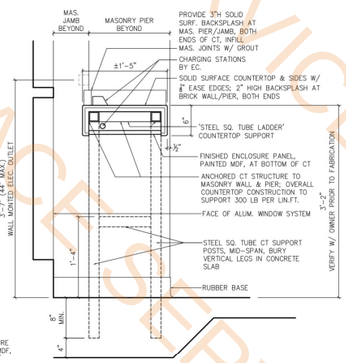


F A5.1 WINDOW COUNTER DETAIL
SCALE: 1" = 1'-0"

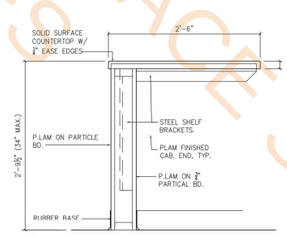


G A5.1 MILLWORK DETAIL
SCALE: 1" = 1'-0"

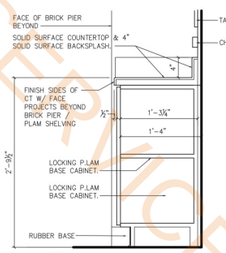


A A5.1 MILLWORK DETAIL
SCALE: 1" = 1'-0"

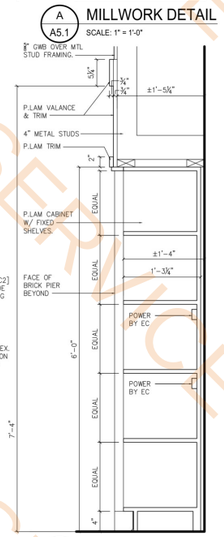


B A5.1 MILLWORK DETAIL
SCALE: 1" = 1'-0"

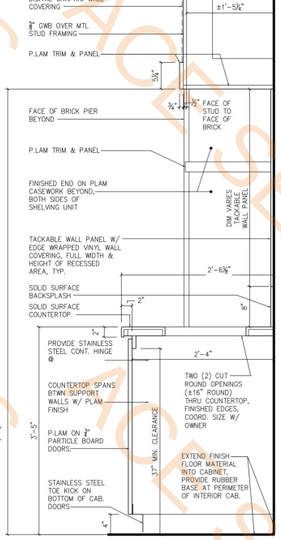

C A5.1 MILLWORK DETAIL
SCALE: 1" = 1'-0"

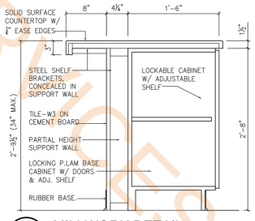

D A5.1 MILLWORK DETAIL
SCALE: 1" = 1'-0"

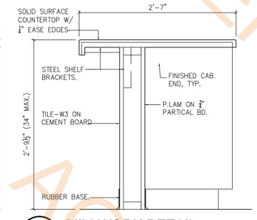

D1 A5.1 MILLWORK DETAIL
SCALE: 1" = 1'-0"

GODSHALL KANE O'ROURKE ARCHITECTS, LLC
300 Brookside Avenue
Ambler Yards - Building 18 - Suite 150
Ambler, PA 19002
T: 215.646.2003 www.gkoarchitects.com

GKO ARCHITECTS

STAMP

CONSULTANTS

ROSE TREE MEDIA
SCHOOL DISTRICT

SPRINGTON LAKE MIDDLE SCHOOL
CAFETERIA ADDITION & RENOVATION
1900 N. PROVIDENCE ROAD, MEDIA, PA. 19063

REVISIONS	

DRAWN BY	LL
REVIEWED	KG
JOB #	2544

SHEET TITLE


INTERIOR ELEVATIONS

SHEET #

A5.1

SCALE	AS NOTED
DATE	1-9-2025

ACE SERVICES

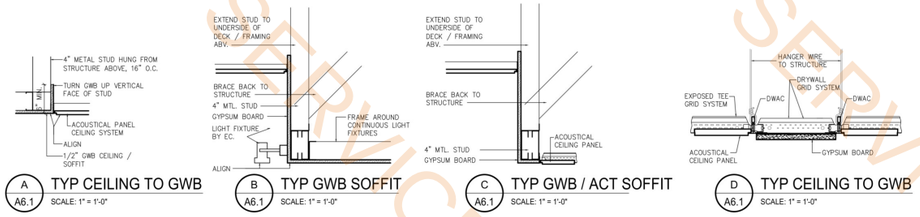

A A6.1 TYP CEILING TO GWB — SCALE: 1" = 1'-0"


B A6.1 TYP GWB SOFFIT — SCALE: 1" = 1'-0"

C A6.1 TYP GWB / ACT SOFFIT — SCALE: 1" = 1'-0"

D A6.1 TYP CEILING TO GWB — SCALE: 1" = 1'-0"




1 A6.1 MAIN LEVEL REFLECTED CEILING PLAN — SCALE: 1/8" = 1'-0"

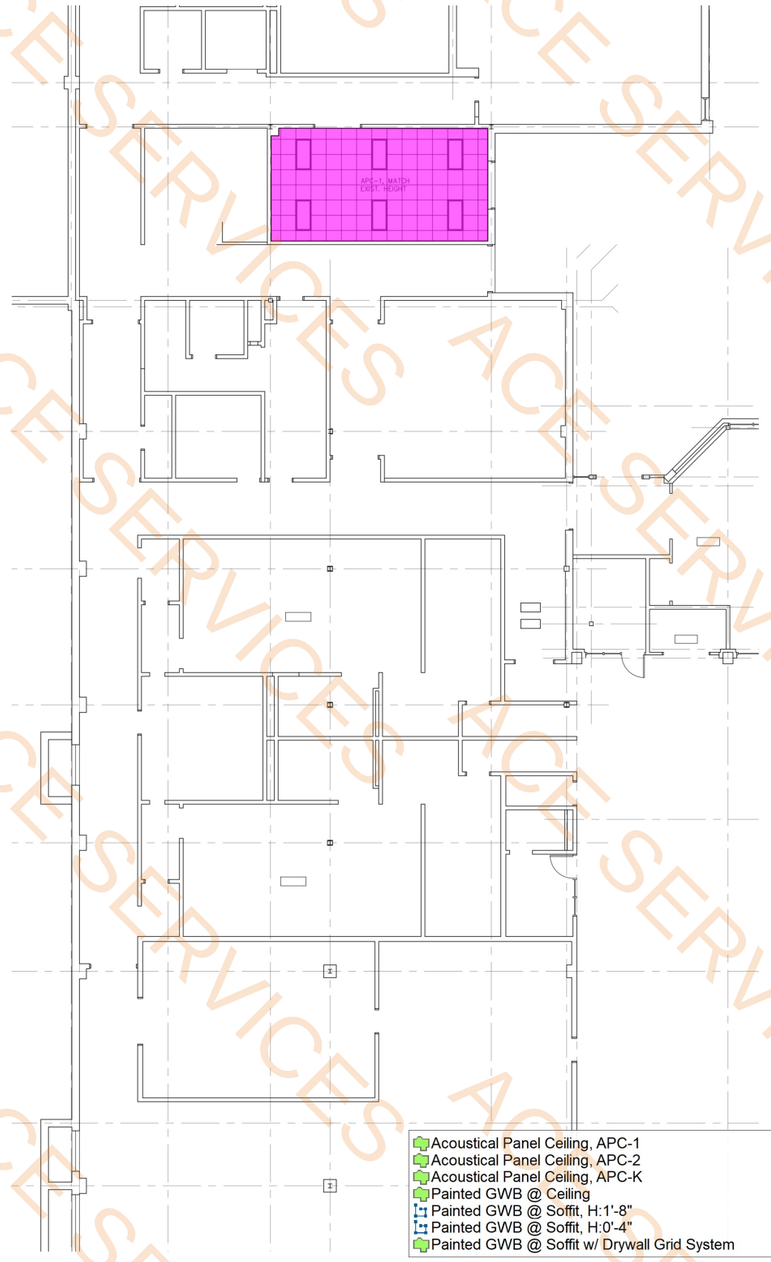

2 A6.1 LOWER LEVEL REFLECTED CEILING PLAN — SCALE: 1/8" = 1'-0"

Acoustical Panel Ceiling, APC-1	5372.5 SQ FT
Acoustical Panel Ceiling, APC-2	1415.9 SQ FT
Acoustical Panel Ceiling, APC-K	1284.8 SQ FT
Painted GWB @ Ceiling	2302.7 SQ FT
Painted GWB @ Soffit, H:1'-8"	250.2 FT
Painted GWB @ Soffit, H:0'-4"	255.8 FT
Painted GWB @ Soffit w/ Drywall Grid System	541.9 SQ FT

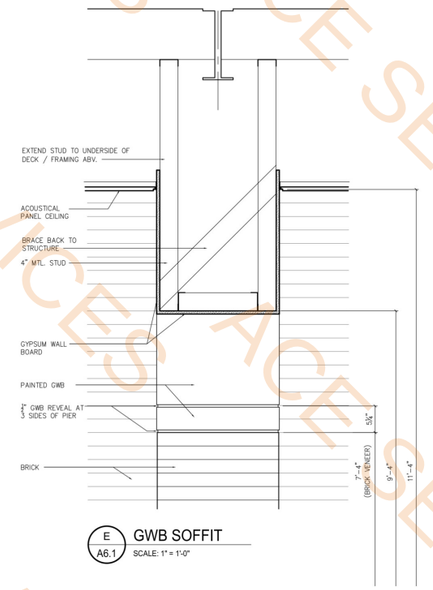

E A6.1 GWB SOFFIT — SCALE: 1" = 1'-0"

RCP GRAPHIC LEGEND

- ACOUSTICAL PANEL CEILING: APC-1
- ACOUSTICAL PANEL CEILING: APC-2
- ACOUSTICAL PANEL CEILING IN KITCHEN & SERVING: APC-K
- PAINTED GWB (GYPSUM WALL BOARD) CEILING/ SOFFIT W/ METAL STUD FRAMING.
- OPEN TO STRUCTURE ABOVE
- LIGHT FIXTURE BY EC (SIZE & SHAPE VARIES)
- EXISTING LIGHT FIXTURE (SIZE & SHAPE VARIES) TO BE REINSTALLED
- EXISTING ACOUSTICAL PANEL CEILING SYSTEM TO REMAIN
- MECHANICAL DIFFUSER / GRILL / UNIT BY HC

LIGHT FIXTURES:

INTERIOR LIGHT FIXTURES:

- DOWNLIGHT
- DOWNLIGHT/DIRECTIONAL
- RING W/ DIRECT/INDIRECT, 72" DIAM.
- RING W/ DIRECT, 72" DIAM.
- TRACK LIGHTING

STAMP

CONSULTANTS

GODSHALL KANE O'ROURKE ARCHITECTS, LLC
300 Brookside Avenue
Ambler Tax Building, Suite 150
Ambler, PA 19002
T: 215.646.2003
www.gkoarchitects.com

GKO ARCHITECTS

ROSE TREE MEDIA SCHOOL DISTRICT
SPRINGTON LAKE MIDDLE SCHOOL
CAFETERIA ADDITION & RENOVATION
1900 N. PROVIDENCE ROAD, MEDIA, PA, 19063

REVISIONS	
DRAWN BY	LL
REVIEWED	KG
JOB #	2544

SHEET TITLE

REFLECTED CEILING PLAN

SHEET #

A6.1

SCALE	AS NOTED
DATE	1-9-2025

ACE SERVICES